# **REQUEST FOR PROPOSAL (RFP)** for Carpentry, Painting, Flooring and Millwork



# **ISSUE DATE: March 1, 2023**

# **RESPONSES DUE:** March 17, 2023

# AWARD NOTIFICATION: March 24, 2023

EQUAL OPPORTUNITY EMPLOYER / PROGRAM

WORK TO BE PERFORMED AT: ACCESS Health Services Building 6450 Maple Road Dearborn, MI 48126

Arab Community Center for Economic and Social Services (ACCESS) strives to enable and empower individuals, families and communities to lead informed, productive and culturally sensitive lives. As a nonprofit model of excellence, we honor our Arab American heritage through communitybuilding and service to all those in need, of every heritage. ACCESS is a strong advocate for cultural and social entrepreneurship imbued with the values of community service, healthy lifestyles, education and philanthropy.



<b>BIDDING INFORMATION</b>					
Issue Date:	March 1, 2023				
Questions Deadline And Walk Thru:	March 10, 2022 by 5:00 PM (EST)         All questions should be submitted in writing via email to Rachid Elabed         relabed@accesscommunity.org.         A scheduled walk thru should occur prior to above deadline.         To be properly received, email Subject line must include:         Health Services Building RFP Question				
Proposal Due Date:	<ul> <li>March 17, 2023 by 5:00pm (EST)</li> <li>Responses must be submitted electronically using the method below:</li> <li>Email proposal to Rachid Elabed at <u>relabed@accesscommunity.org</u>. To be properly received, email Subject line must include: Health Services Building RFP Response</li> <li>Bid submissions must include (1) completed Excel pricing summary and (1) completed PDF response to the overall RFP (per Section VI. C. Submittal Information)</li> <li>ACCESS WILL NOT ACCEPT PAPER/HARD COPY OR LATE PROPOSALS</li> </ul>				
Award Notice:	March 24, 2023				
Contract Start Date:	The contract period is scheduled to begin March 24, 2023				



# Contents

I.	INTRODUCTION	. 4
II.	CONFIDENTIALITY	. 4
III.	ORGANIZATION QUALIFICATIONS	. 4
IV.	SCOPE OF WORK	. 5
V.	PROPOSAL REQUIREMENTS	.9
VI.	RFP PROCESS AND PROCEDURES	.9



#### I. INTRODUCTION

ACCESS is seeking to secure one firm to provide the following Scope of Work, Electrical, Millwork and Plumbing, Flooring and Tile, and Painting Services.

ACCESS plans to award one (1) contract for requested services.

#### **II. CONFIDENTIALITY**

ACCESS will treat as confidential any non-public information that we receive from you in our discussions about the transaction contemplated by your RFP (other than information that we also receive from other, non-confidential sources, or that we independently develop ourselves).

#### **III. ORGANIZATION QUALIFICATIONS**

Eligible applicants include non-profit organizations, private for-profit companies, units of local government including community colleges and universities, and faith-based and community organizations.

Organizations and individuals are ineligible if they are currently barred, suspended, proposed for debarment, declared ineligible, or voluntarily excluded from participation in this transaction by a federal department/agency, or if they are not in compliance with the State of Michigan Department of Revenue or Internal Revenue Service requirements.

Applicants must possess the following credentials:

- Maintain all required licenses, bonding, equipment, and identified core personnel necessary to perform the work as required in the RFP;
- Have a Certificate of Incorporation; and
- Personnel policies and procedures demonstrating compliance with Equal Employment Opportunities requirements, Americans with Disability Act, and Drug Free Workplace and Byrd Anti-Lobbying Act.

The contractor must be able to comply with all state of Michigan regulations as well as any other county, local or federal laws or regulations as required to lawfully provide the services.

Applicants must assure the ability to comply with all applicable laws and regulations, as well as the nondiscrimination and equal opportunity provisions of 29 C.F.R. § 38.25, if awarded a contract and remain in compliance for the duration of the award.

Applicants must be financially and operationally stable and must possess sufficient scale in terms of staff and other resources to support ACCESS throughout the term of a contract, if awarded as a result of this RFP.

To be considered for an award for this service, the proposing organization or individual must have <u>at</u> <u>least five (5) years'</u> experience representing public agencies, non-profit organizations, federal grant recipients and organizations of similar scope and size.



#### IV. SCOPE OF WORK

ACCESS is seeking to secure one firm to provide the procurement and installation of the following services:

Electrical, Millwork and Plumbing, Flooring and Tile, and Painting per the attached Scope Documents.

Sheet A0.01 First Floor Existing Plan – 1/8" Scale

Sheet A0.02 Second Floor Existing Plan – 1/8" Scale

Sheet A2.10 First Floor Lighting and Electrical Plan – 3/16" Scale

Sheet A2.20 Second Floor Lighting and Electrical Plan – ¼" Scale

Sheet A-8.10 First Floor Carpentry and Millwork Plan – 3/16" Scale

Sheet A-8.20 Second Floor Carpentry and Millwork Plan - 1/4" Scale

Sheet A9.10 First Floor Flooring and Finish Plan – 3/16" Scale

Sheet A9.20 Second Floor Flooring and Finish Plan – <sup>1</sup>/<sub>4</sub>" Scale

The scope will consist of but not limited to the following.

- 1. Bidder to provide a schedule of duration for the project including start and end dates.
- 2. Bidder to coordinate all final electrical locations with furniture provider.
- 3. All Bidders shall review the New Scope of Work documents and compare to the existing conditions.
- 4. The scope of work for this project will be a Design/Build opportunity, Bidders shall include the cost of producing a set of documents able to convey the final scope and be used for Permitting and for trade use to execute the renovation, including all necessary details. CAD files will be provided to the awarded Bidder for use in producing the final Documentation.
- 5. Bidders to include pricing for New and/or relocating all HVAC diffusers as required for the project including air balance.
- 6. Bidders to include pricing for New and/or relocating all Fire Suppression Heads as required for the project.
- 7. Card Access programing, contacts, card readers, electric strikes and mag lock hardware provided by ACCESS.
- 8. Security cameras, wiring, programing labor and material provided by ACCESS.
- 9. Branding, Graphics and signage provided by ACCESS.
- 10. Fire Alarm system including New and or relocating of strobes provided by ACCESS.



## **First Floor**

- 1. Lobby 100
  - a. Demo Flooring and Base.
  - b. Demo Reception Desk.
  - c. Demo Decorative Columns.
  - d. New Reception Desk by others.
    - i. Bidder to provide Electrical to and under desk.1
  - e. New pendant lights above reception desk.
  - f. New Ceramic Tile and ceramic base.
  - g. Paint walls and soffits.
- 2. Waiting Area 101, Clinic Reception 102
  - a. Demo Clinic Check Desk.
  - b. Demo Half Wall and existing millwork.
  - c. Demo Flooring and Base.
  - d. New Secure Clinic Reception counter with glass above.
    - i. Provide power for each check in area.
  - e. New Flooring and base.
  - f. New opening for Clinic Checkout Millwork by others.
  - g. New lighting Clinic Check in and out locations recessed cans.
  - h. Paint walls and soffits.
- 3. New Triage 112
  - a. New Millwork and Plumbing fixture.
  - b. Bidder to provide new privacy curtain.
  - c. Rework lighting as required.
  - d. Patch and paint walls as needed due to rework of space.
- 4. Existing Exam Rooms 114, 115, 117, 118, 119, 120, 124, 125, 126, 127
  - a. Demo Existing Millwork.
  - b. Demo Existing Flooring and Base.
  - c. New Millwork to match existing layout and sink locations.
  - d. New Flooring and Base.
- 5. Lab Room 131
  - a. Demo Existing Millwork.
  - b. Demo Existing Flooring and Base.
  - c. New Millwork to match existing layout and sink locations.
    - i. Bidder to provide under cabinet lighting.
    - ii. Bidder to include new plumbing fixtures.
  - d. New Flooring and Base.
  - e. Paint walls and soffits.



- 6. Provider Area 130
  - a. Demo Walls as required.
  - b. Demo/Rework lighting as required.
  - c. Demo/Rework electrical as required.
  - d. Demo Flooring and base.
  - e. New furniture by others
  - f. New Flooring and base.
  - g. Repair all Gyp board as required due to demo.
  - h. Paint walls and soffits.
- 7. Office 134 and 135
  - a. Demo Flooring and base.
  - b. New Flooring and base.
  - c. Paint walls and soffits.
- 8. WIC
  - a. Demo Flooring and base.
  - b. Demo gyp board walls as required for new layout.
  - c. Demo/Rework lighting as required.
  - d. Demo/Rework electrical as required.
  - e. Demo finishes in Restrooms, including flooring, base, ACT, plumbing fixtures and lighting.
  - f. New plumbing fixtures, flooring and ACT in Restrooms
  - g. New lighting in Restrooms
  - h. New furniture by others.
  - i. New Gyp Walls.
  - j. New Doors, Frames and Borrowed lites.
  - k. New Flooring and base.
  - 1. Repair all Gyp board as required due to demo.
  - m. Paint walls and soffits.
- 9. Mens/Womens Toilet Rooms
  - a. Demo Flooring and Base.
  - b. Demo Toilet Partitions.
  - c. Demo Plumbing Fixtures
  - d. Demo Millwork
  - e. Demo ACT
  - f. New Millwork
  - g. New Plumbing fixtures
    - i. Bidder to provide power to all locations for hardware flush valves.
  - h. New Toilet Partitions.
  - i. New ACT
  - j. New Lighting
  - k. Paint walls and soffits.



## 2<sup>nd</sup> Floor

- 1. Demo all Flooring and Base.
- m. Paint walls and soffits.
- 10. Lobby/Reception 201
  - a. Demo existing reception desk.
  - b. New reception desk by others.
    - i. Bidder to provide power to new reception desk.
  - c. New Pendant lights above Reception Desk.
  - d. New Glass Wall with door, prep door for Card Access
    - i. Bidder to provide prep for card access, Strike and programing by others.
  - e. Provide power for new phone booth 233.
- 11. Office Area
  - a. Demo existing gyp wall as required for new layout.
  - b. Demo existing door into Lobby and save for reuse.
  - c. Install saved door in new location.
  - d. Patch/Repair all gyp as required due to demo.
  - e. Furniture by others.
- 12. Training Room 214
  - a. Demo millwork and plumbing fixtures.
  - b. New millwork and plumbing fixtures.
- 13. Kitchenette 217
  - a. Demo millwork and plumbing fixtures.
  - b. New millwork and plumbing fixtures.
- 14. Mens/Womens Toilet Rooms
  - a. Demo Flooring and Base.
  - b. Demo Toilet Partitions.
  - c. Demo Plumbing Fixtures
  - d. Demo Millwork
  - e. Demo ACT
  - f. New Millwork
  - g. New Plumbing fixtures
    - i. Bidder to provide power to all locations for hardware flush valves.
  - h. New Toilet Partitions.
  - i. New ACT
  - j. New Lighiting
  - k. Paint walls and soffits.
- 15. Counseling Rooms
  - a. Demo existing gyp as required for new borrowed lights
  - b. Provide and install new borrowed lights.
  - c. Furr out exterior wall with 2" studs and provide insulation.



### V. PROPOSAL REQUIREMENTS

<u>Accuracy and completeness of information</u>. All information pertaining to the prospective applicant's approach in meeting the requirements of the RFP shall be organized and presented in the prospective applicant's proposal. The instructions contained in this RFP must be strictly followed.

<u>Accuracy and completeness are essential</u>. Omissions and ambiguous or equivocal statements will be viewed unfavorably and may be considered in the evaluation. Since all or a portion of the successful proposal may be incorporated into any ensuing contract, all applicants are further cautioned not to make any claims or statements that cannot be subsequently included in a legally binding agreement.

#### Ambiguous or inaccurate budget information is a basis for proposal disqualification.

#### VI. RFP PROCESS AND PROCEDURES

#### A. Preparation of Proposals

The proposal must be provided on the attached pricing documents.

#### **B.** Changes in Proposal Requirements

ACCESS may make changes to the requirements of this RFP as it deems necessary. Such changes will be in writing, issued by ACCESS and will be sent to each vendor who has formally identified themselves as a potential responder. If changes are made, ACCESS may, at its discretion, extend the time allowed for submission of proposals.

#### C. Submittal Information

Prospective vendors shall submit their proposals in the following order and must contain the elements listed below, including all applicable attachments:

#### 1. Cover Letter

#### 2. Table of Contents

#### 3. Summary

Provide a two (2)-page summary of the proposal that outlines the bidding vendor's background and history of experience providing construction services.

Provide a list of clients and experience working with non-profits of a similar size and nature to ACCESS.

#### 4. Qualifications

Applicant shall provide the following information that describe qualifications to successfully carry out activities described in the RFP.



- a) Proposal should also describe how many years of experience individual team members in their prospective fields have. Identify key staff on your team that may be assigned to ACCESS. As applicable, information must include:
  - i. Name
  - ii. Title
  - iii. Brief description of their role
  - iv. Years of experience
- b) Provide documentation of Incorporation (inc. LLC, etc.)

#### 5. Performance History

The applicant shall provide the following information that demonstrate a proven track record:

a) List at least three (3) customer references, including names, mailing address, email addresses, and contact numbers, that can attest to the qualifications presented in this bid.

#### 6. Service Delivery Description

The applicant shall provide the following information that describes a customer-focused service delivery model.

- a) Describe estimate projected timelines for completion for key deliverables in the project scope.
- b) Describe how projects are managed to ensure timely delivery if services.
- c) Describe your hours of operation including:
  - i. Standard Business (Days and Time)
  - ii. After Hours (Days and Times)
  - iii. Holidays



#### **Price Proposal**

Bidders are required to complete the completed Excel pricing summary sheets.

ACCESS reserves the right to select proposals from the most qualified firms with competitive pricing. ACCESS will select one firm to perform the Scope of Work outlined in this RFP.

#### **D.** Evaluation Procedures, Oral Presentations, and Site Inspections

Following the receipt of the applicant's proposal, ACCESS designated evaluation committee will evaluate each response. All proposals which meet the required format of this RFP will be evaluated. Any proposal determined to be non-responsive to the specifications or other requirements of the RFP, including instructions governing submission and format, will be disqualified unless ACCESS determines, at its sole discretion, that noncompliance is not substantial or that an alternative proposal by the prospective vendor is acceptable.

ACCESS reserves the right to request additional information to amplify, clarify, or support proposals. ACCESS also reserves the right, at its own discretion, to request oral presentations regarding proposals submitted in response to the RFP. Failure to make an oral presentation after one is requested by ACCESS will be grounds for rejection of your proposal.

#### 1. Vendor Selection Criteria

ACCESS reserves the right to reject any or all proposals, in-part or in-total, for any objective or subjective reason whatsoever. If a proposal is selected, it will be the most advantageous based on the quality of service, the Vendors' qualifications, and capabilities to provide the specified service, and other factors which the ACCESS may consider. ACCESS does not intend to award a bid fully on the basis of any response made to the proposal; ACCESS reserves the right to consider proposals for modifications at any time before a proposal is awarded, and negotiations will be undertaken with that Vendor whose proposal is deemed to best meet ACCESS' specifications and needs.

#### Quote To: Rachid Elabed

6450 Maple Street 2/23/23 8:15 AM

Phone:

Ship To: Rachid Elabed 6450 Maple Street Dearborn, MI 48126

Em	ail: relabed@accesscommunity.org		<u>Account</u>	<u>Rep.:</u>			Quote #		
	2000°	Description	Price						
01									
02									
06									
061									
091									
093	Paints and Coatings								
152	Plumbing								
16									
	Total Price								
Cooo Cooo	<sup>1</sup> %00	Description						Total Price	
10	General Conditions								
	Total from Break out Sheets								
	Architectural, Permitting and Do	cumentation			 				
	Total from Break out Sheets								
	Millwork		 					<u> </u>	
	Total from Break out Sheets								
					 		1		
	Rough Carpentry		 					<u> </u>	
	Total from Break out Sheets								
	Flooring								
	Total from Break out Sheets							<u> </u>	
	Painting								
	Total from Break out Sheets								
	Total HOIT Break Out Sheets							<u> </u>	
	Plumbing								
	Total from Break out Sheets								
	Total Holli Dieak out Sheets						1	<u> </u>	
	Electrical								
	Total from Break out Sheets								
1	1. Stat. Horri Broak out onoolo						1	1	



#### Quote To: Rachid Elabed

6450 Maple Street 2/23/23 8:15 AM

Phone: Email: relabed@accesscommunity.org Ship To: Rachid Elabed 6450 Maple Street Dearborn, MI 48126

Account Rep .:

Quote #

**Clarifications:** 



#### ACCESS 6450 Maple Renovation 1st and 2nd Floor

#### Quote To: Rachid Elabed

6450 Maple Street 2/23/23 8:15 AM

#### Ship To: Rachid Elabed 6450 Maple Street Dearborn, MI 48126

<u>Phone</u> <u>Email</u>	relabed@accesscommunity.org	<u>Accoun</u>	it Rep.:			Quote #	]
Co009	Description	Price					
06	Millwork						
061	Rough Carpentry						
091	Flooring						
093	Paints and Coatings						
16	Electrical						
•	Total Price						

Code 2	S Description	Qty	Unit	Material	Тах	Labor	Other Costs		Total Price
10	General Conditions								
	Project Manager	1	LS						
	Project Administration	1	LS						
	Temporary Barricades, Dust Protection, Enclosures	1	LS						
	Cleaning (progress, final)	1	LS						
	Closeout Submittals	1	LS						
	Dumpsters	1	LS						
10	Architectural, Permitting and Documentation								
	Architectural Documents	1	LS						
	Permitting	1	LS						
	Millwork								
	Millwork - Demo								
	Demo Existing Millwork	1	LS						
	Demo Existing Sinks in areas of New Millwork	5	EA						
	Millwork - New								
	New Millwork with Solid Surface Top	1	LS						
	New Millwork with HPL Laminate base and Uppers	1	LS						
	New Millwork HPL Laminate Sink Top for Toilet Rooms	4	EA						
	New Reception Desks, 1st and 2nd Floor Allowance	2	EA	Use \$25,00	0 Allowance	Total			
	Millwork - Plumbing								
	New Undermount Sinks - All Sinks	1	LS					1	



#### ACCESS 6450 Maple Renovation 1st and 2nd Floor

#### Quote To: Rachid Elabed


6450 Maple Street 2/23/23 8:15 AM


Ship To: Rachid Elabed 6450 Maple Street Dearborn, MI 48126

Pho Em	<u>ne:</u> <u>ail:</u> relabed@accesscommunity.org	Accoun	ut Rep ·		Quote #	
<u></u>		<u>/ 1000ull</u>	<u></u>		Quoto "	
	Rough Carpentry					
1	Demo Columns 1st floor	1	LS			
V	Patch All Walls Due to Demo	1	LS			
1	Patch Soffits Due to Demo	1	LS			
	Demo Door 205 and Move	1	LS			
	Patch Wall Due to 205 Door Move and Make Ready for Paint	1	LS			
	Patch Walls Due to Millwork Demo 205	1	LS			
	Patch all Walls Due to any Demo, Minor Wall Repair Include with Painting	1	LS			
	Furr out Existing Exterior Wall with 2" Metal Stud and Insulation - Offices and Conf Rm	1	LS			
	New Corridor Door 201	1	LS			
	Flooring					
	Flooring Demo Existing Flooring	1	LS			
	Provide and Install New Carpet Tile	1	LS			
	Provide and Install New Carpet Tile Provide and Install New Ceramic Tile and Base	1	LS			
	Provide and Install New Ceramic Tile and Base	1	LS			
	Demo Existing Flooring - Toilet Rooms	1	LS			
	New Tile Flooring and Base - Toilet Rooms	1	LS			
	New Tile on Wet Walls - Approx 600 s.f Toilet Rooms	1	LS			
	New Tile on Drinking Fountain Wall - Approx. 180 s.f Toilet Rooms	1	LS			
		I	- 10			
	Painting					
	Prep/Deprep Area - Ready for Paint Including Minor Patching	1	LS			
	Painting of Doors and Frames	43	EA			
1	Plumbing					
	Automatic Flush Valves	7	EA			
-	New Lav Faucet with Autoflush Valves	4	EA			
-	Remove and Install New Elkay EMABFTL8WSLK	1	EA			
	Remove and Install Existing Toilet Fixtures	7	EA			
				· · · · · · · · · · · · · · · · · · ·		
	Electrical					
	Demo of Electrical at Reception Desk	1	LS			
	New Can Lights	7	EA			
	New Undercabinet Lighting	1	LS			
	New Pendant Light over Reception Desks	5	EA	Use \$1,000 Per Fixture Allowance		
	New/Rework Electrical for New Furniture Layout	1	LS			
	New Duplex Outlets as required for the new Layout	1	LS			
	Power for Automatic Flush Valves	22	EA			




**F**space matters

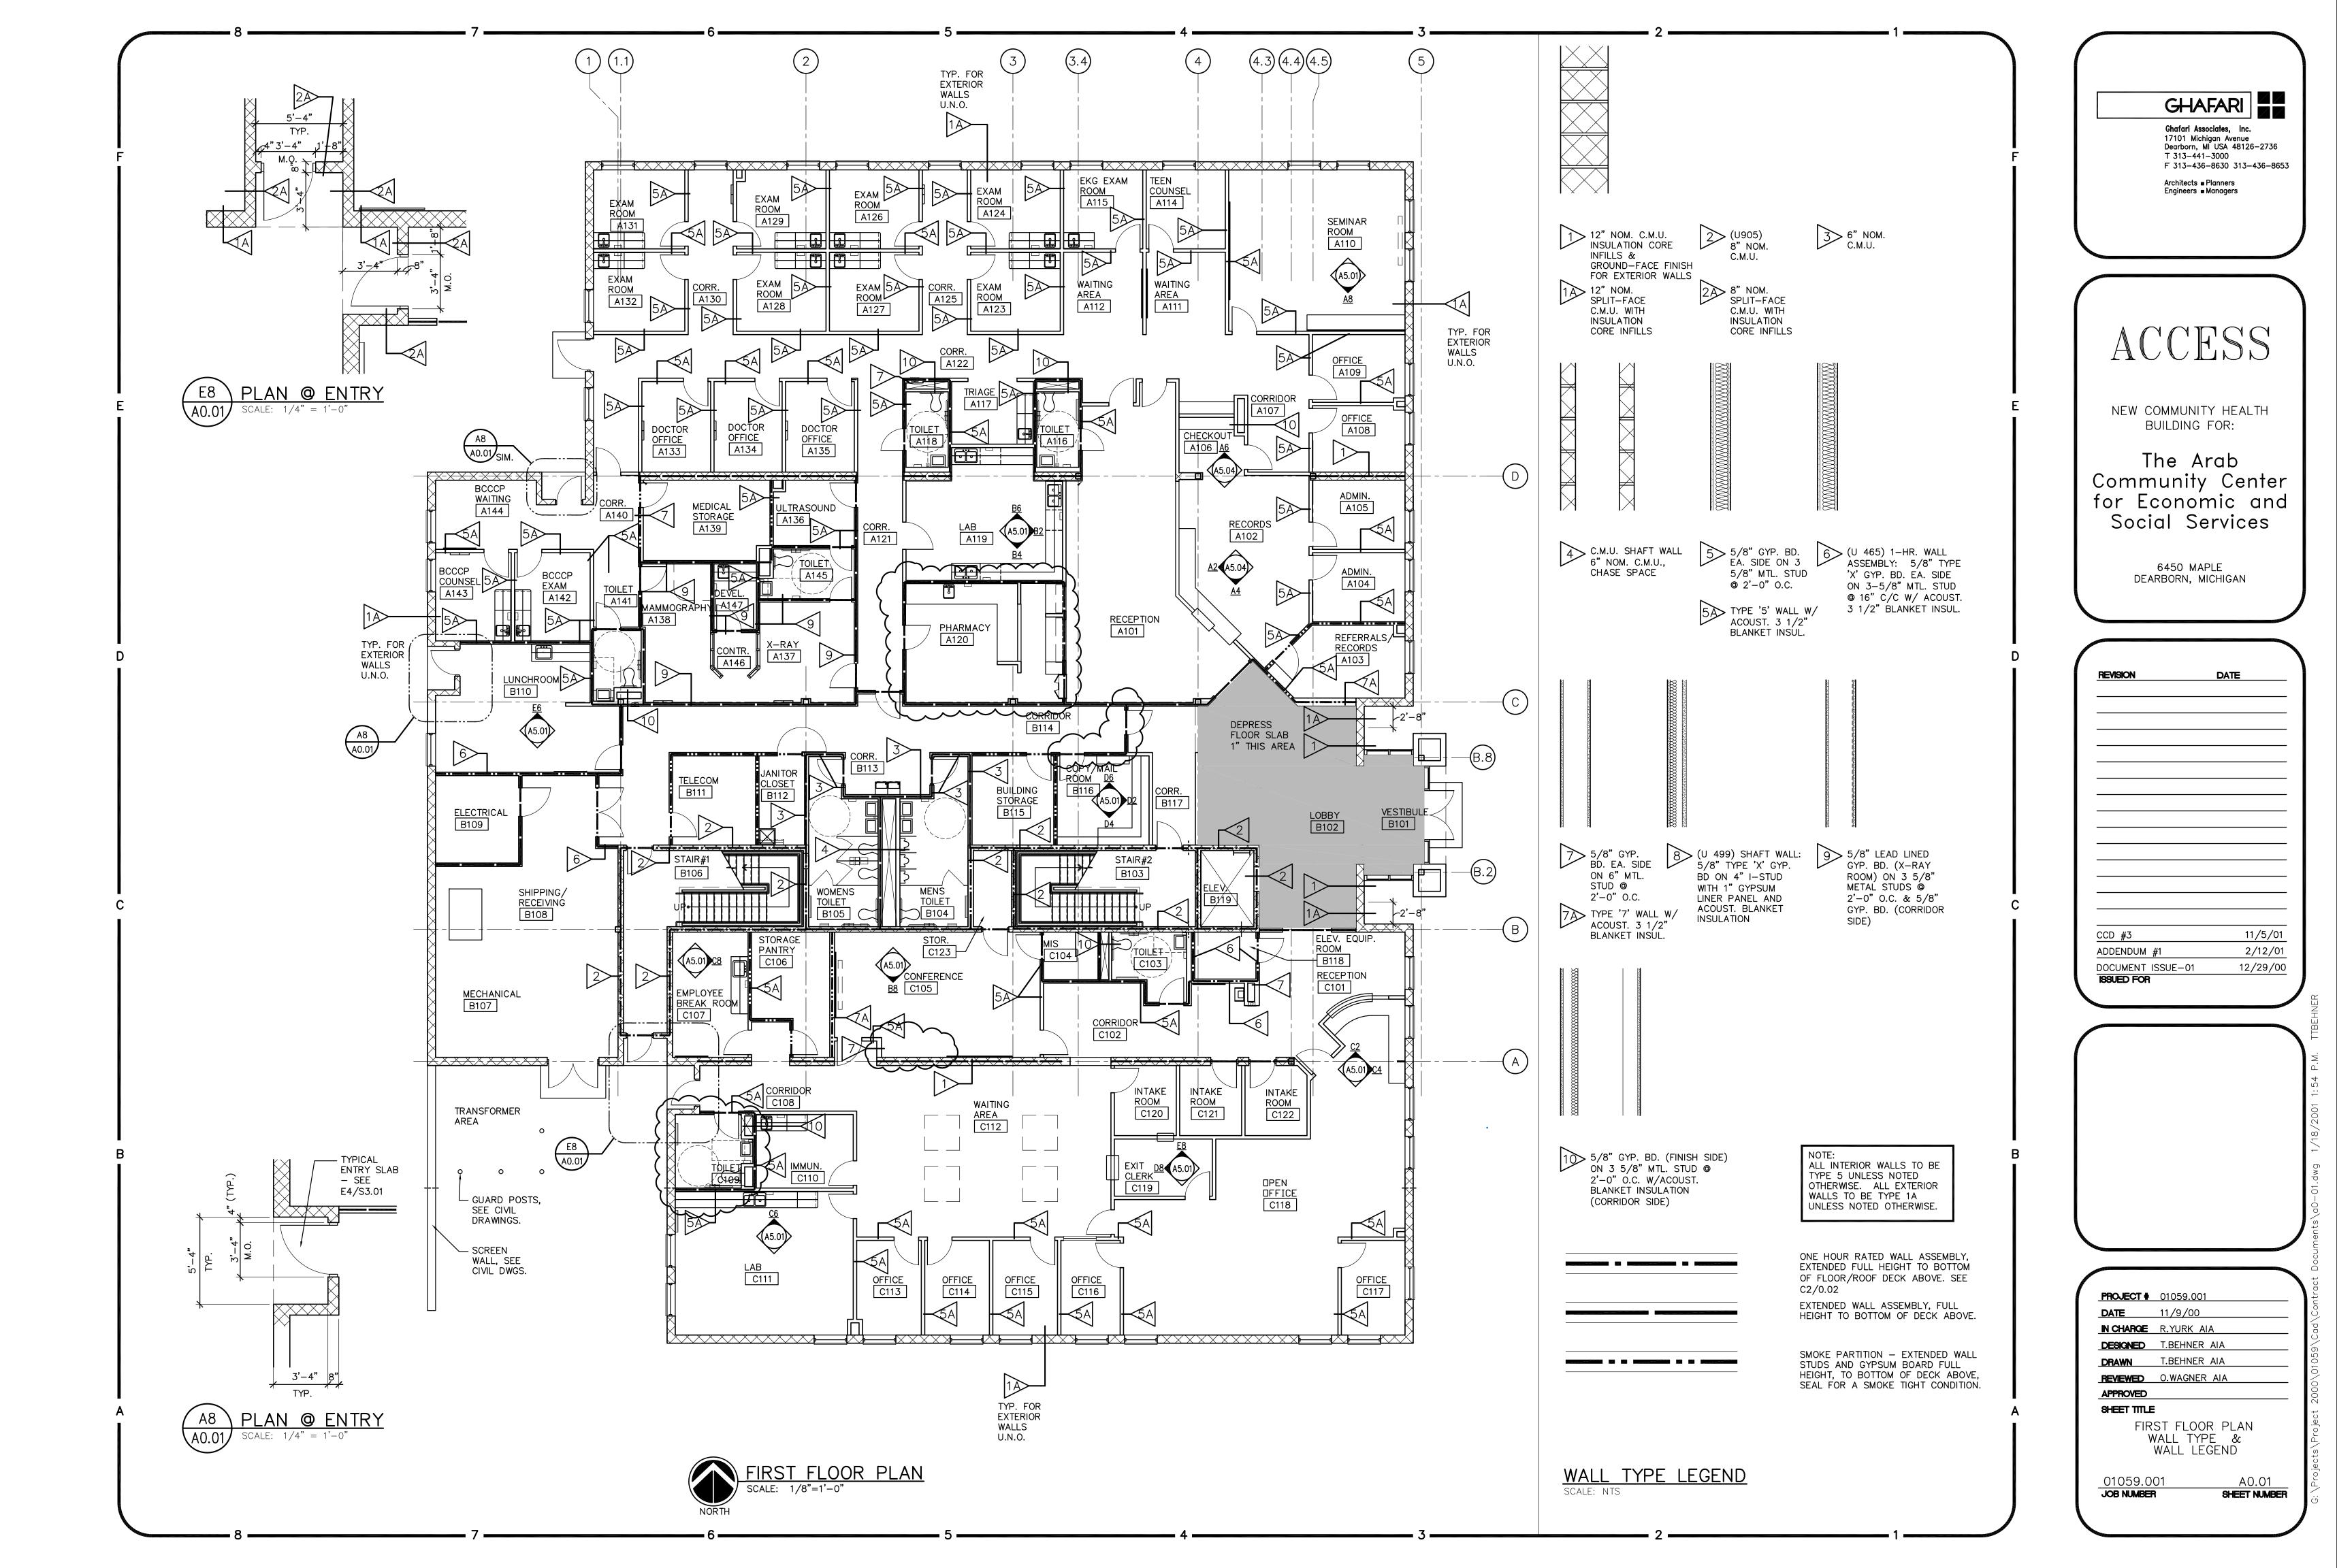


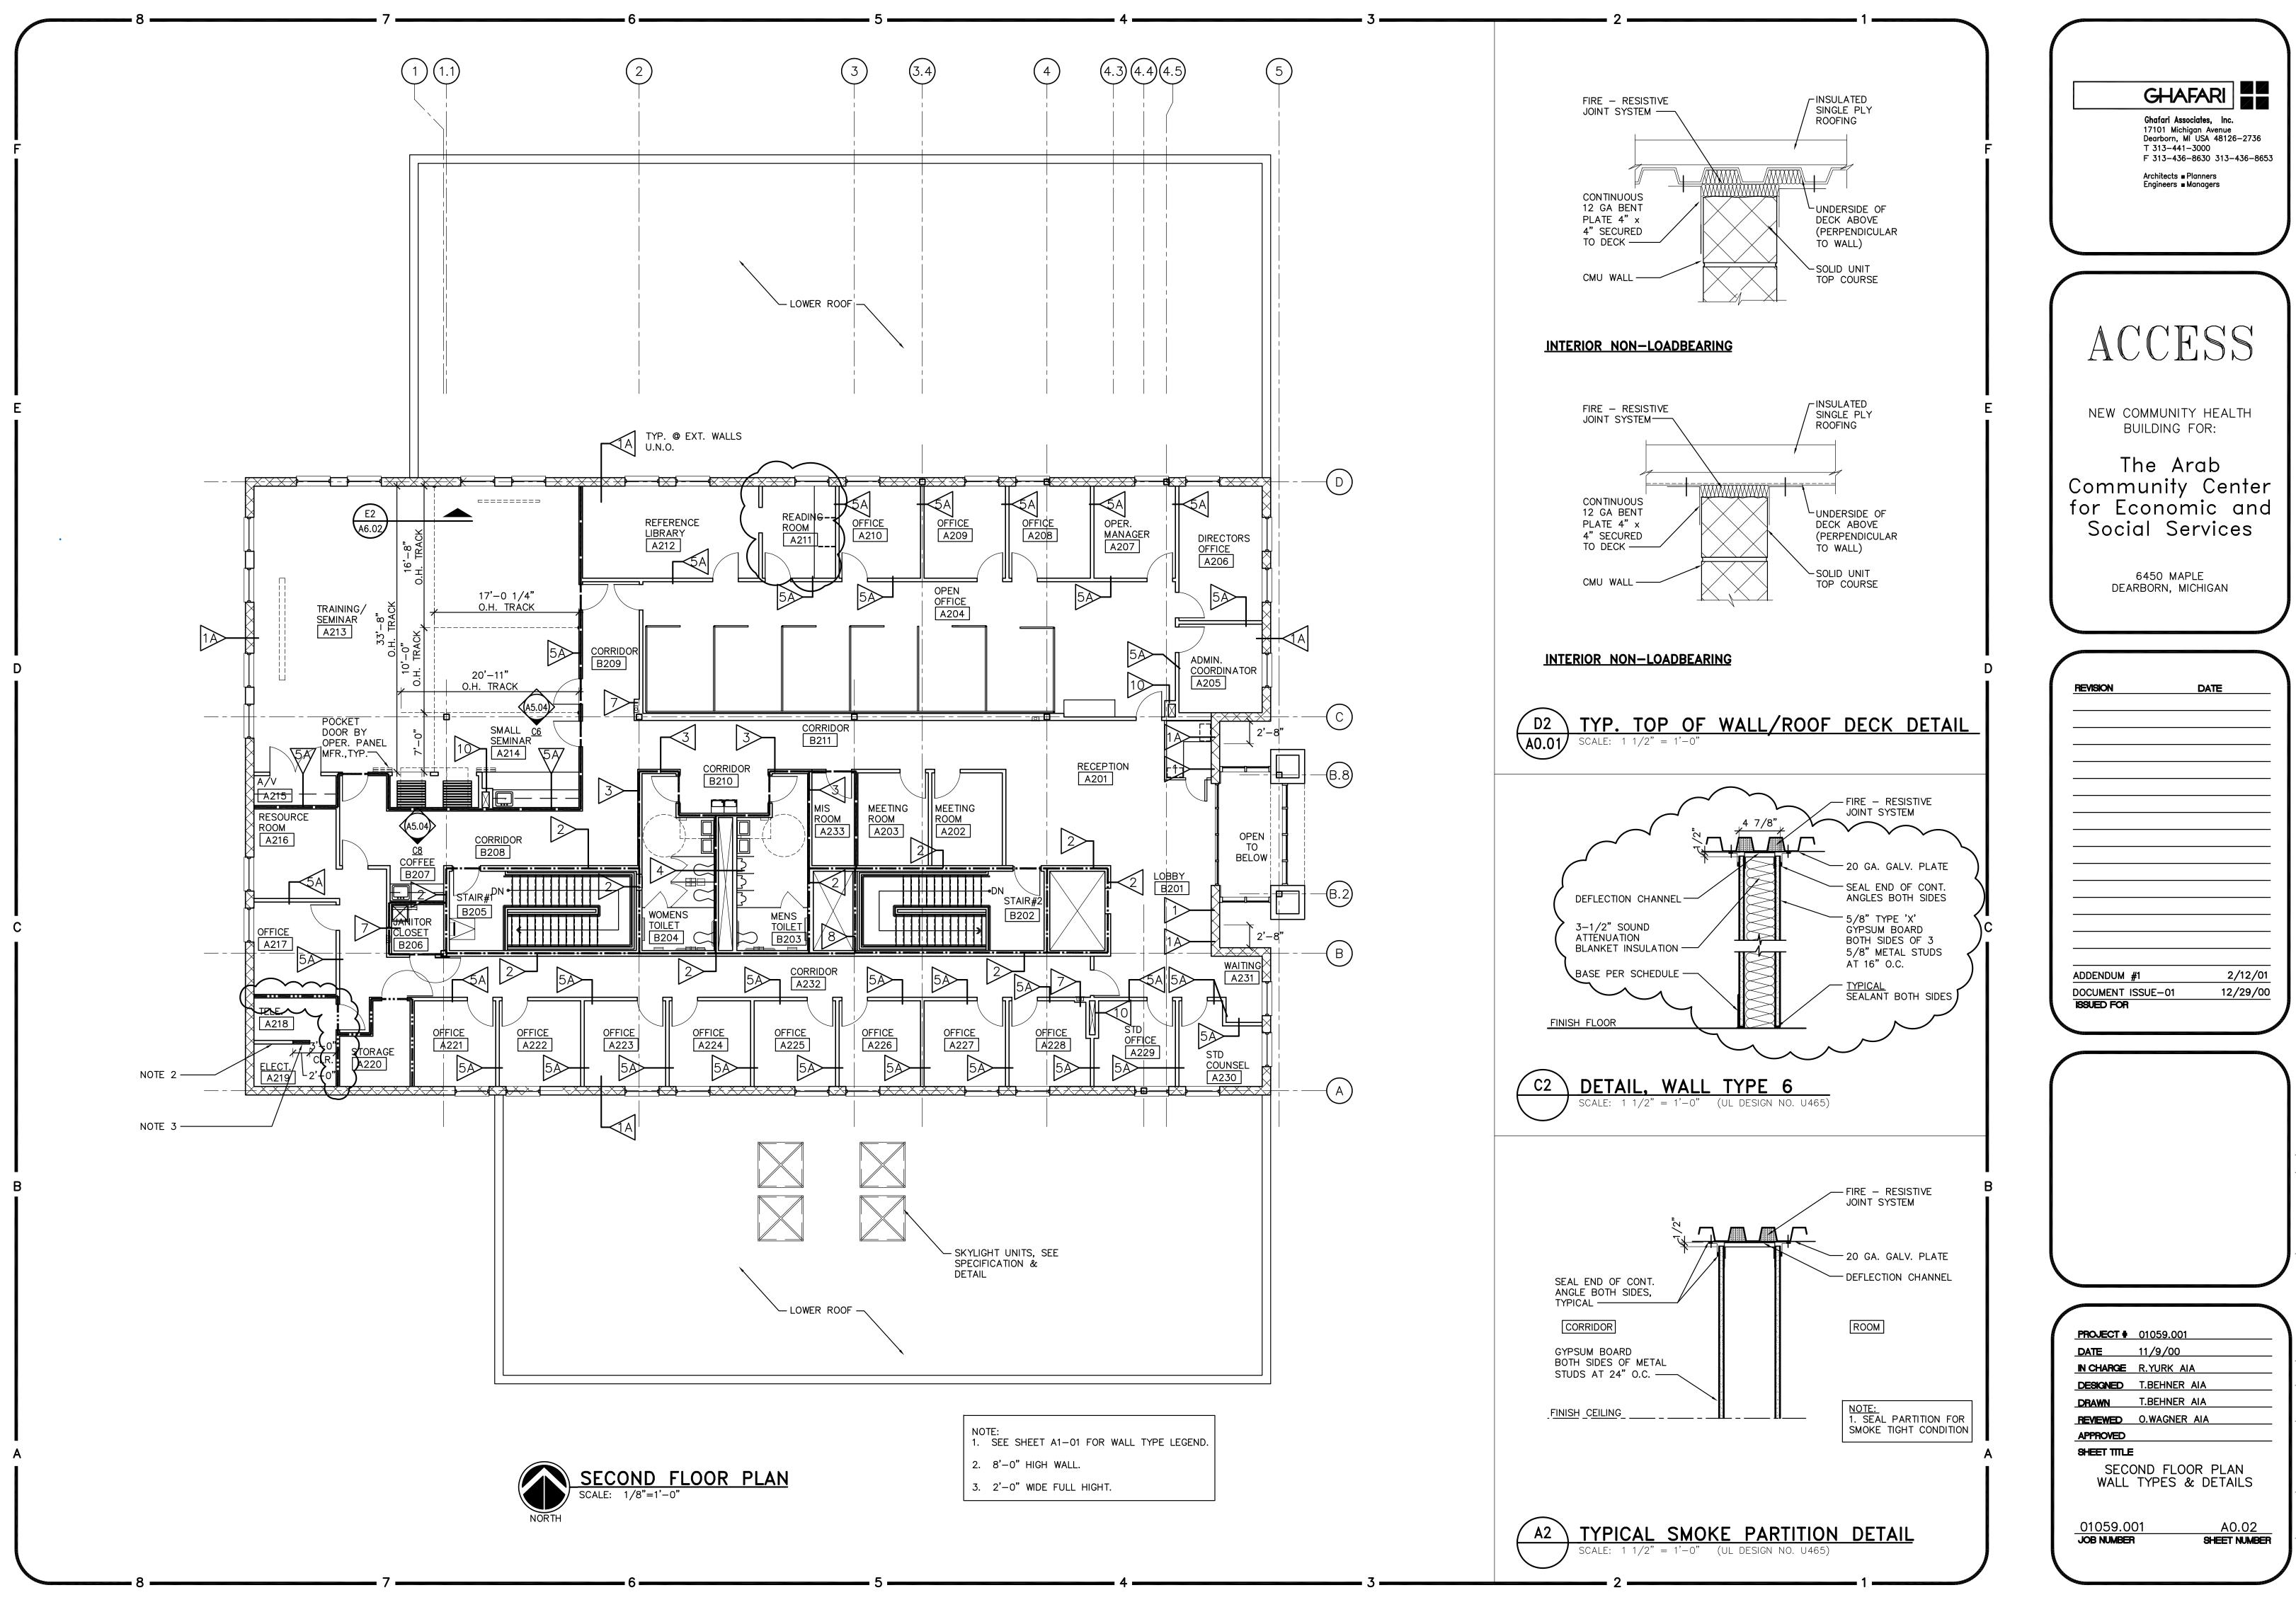

: \Projects\Project 2000\01059\Cad\Contract Documents\a0-02.dwg 1/16/2001 0:38 P.M. CJFLE

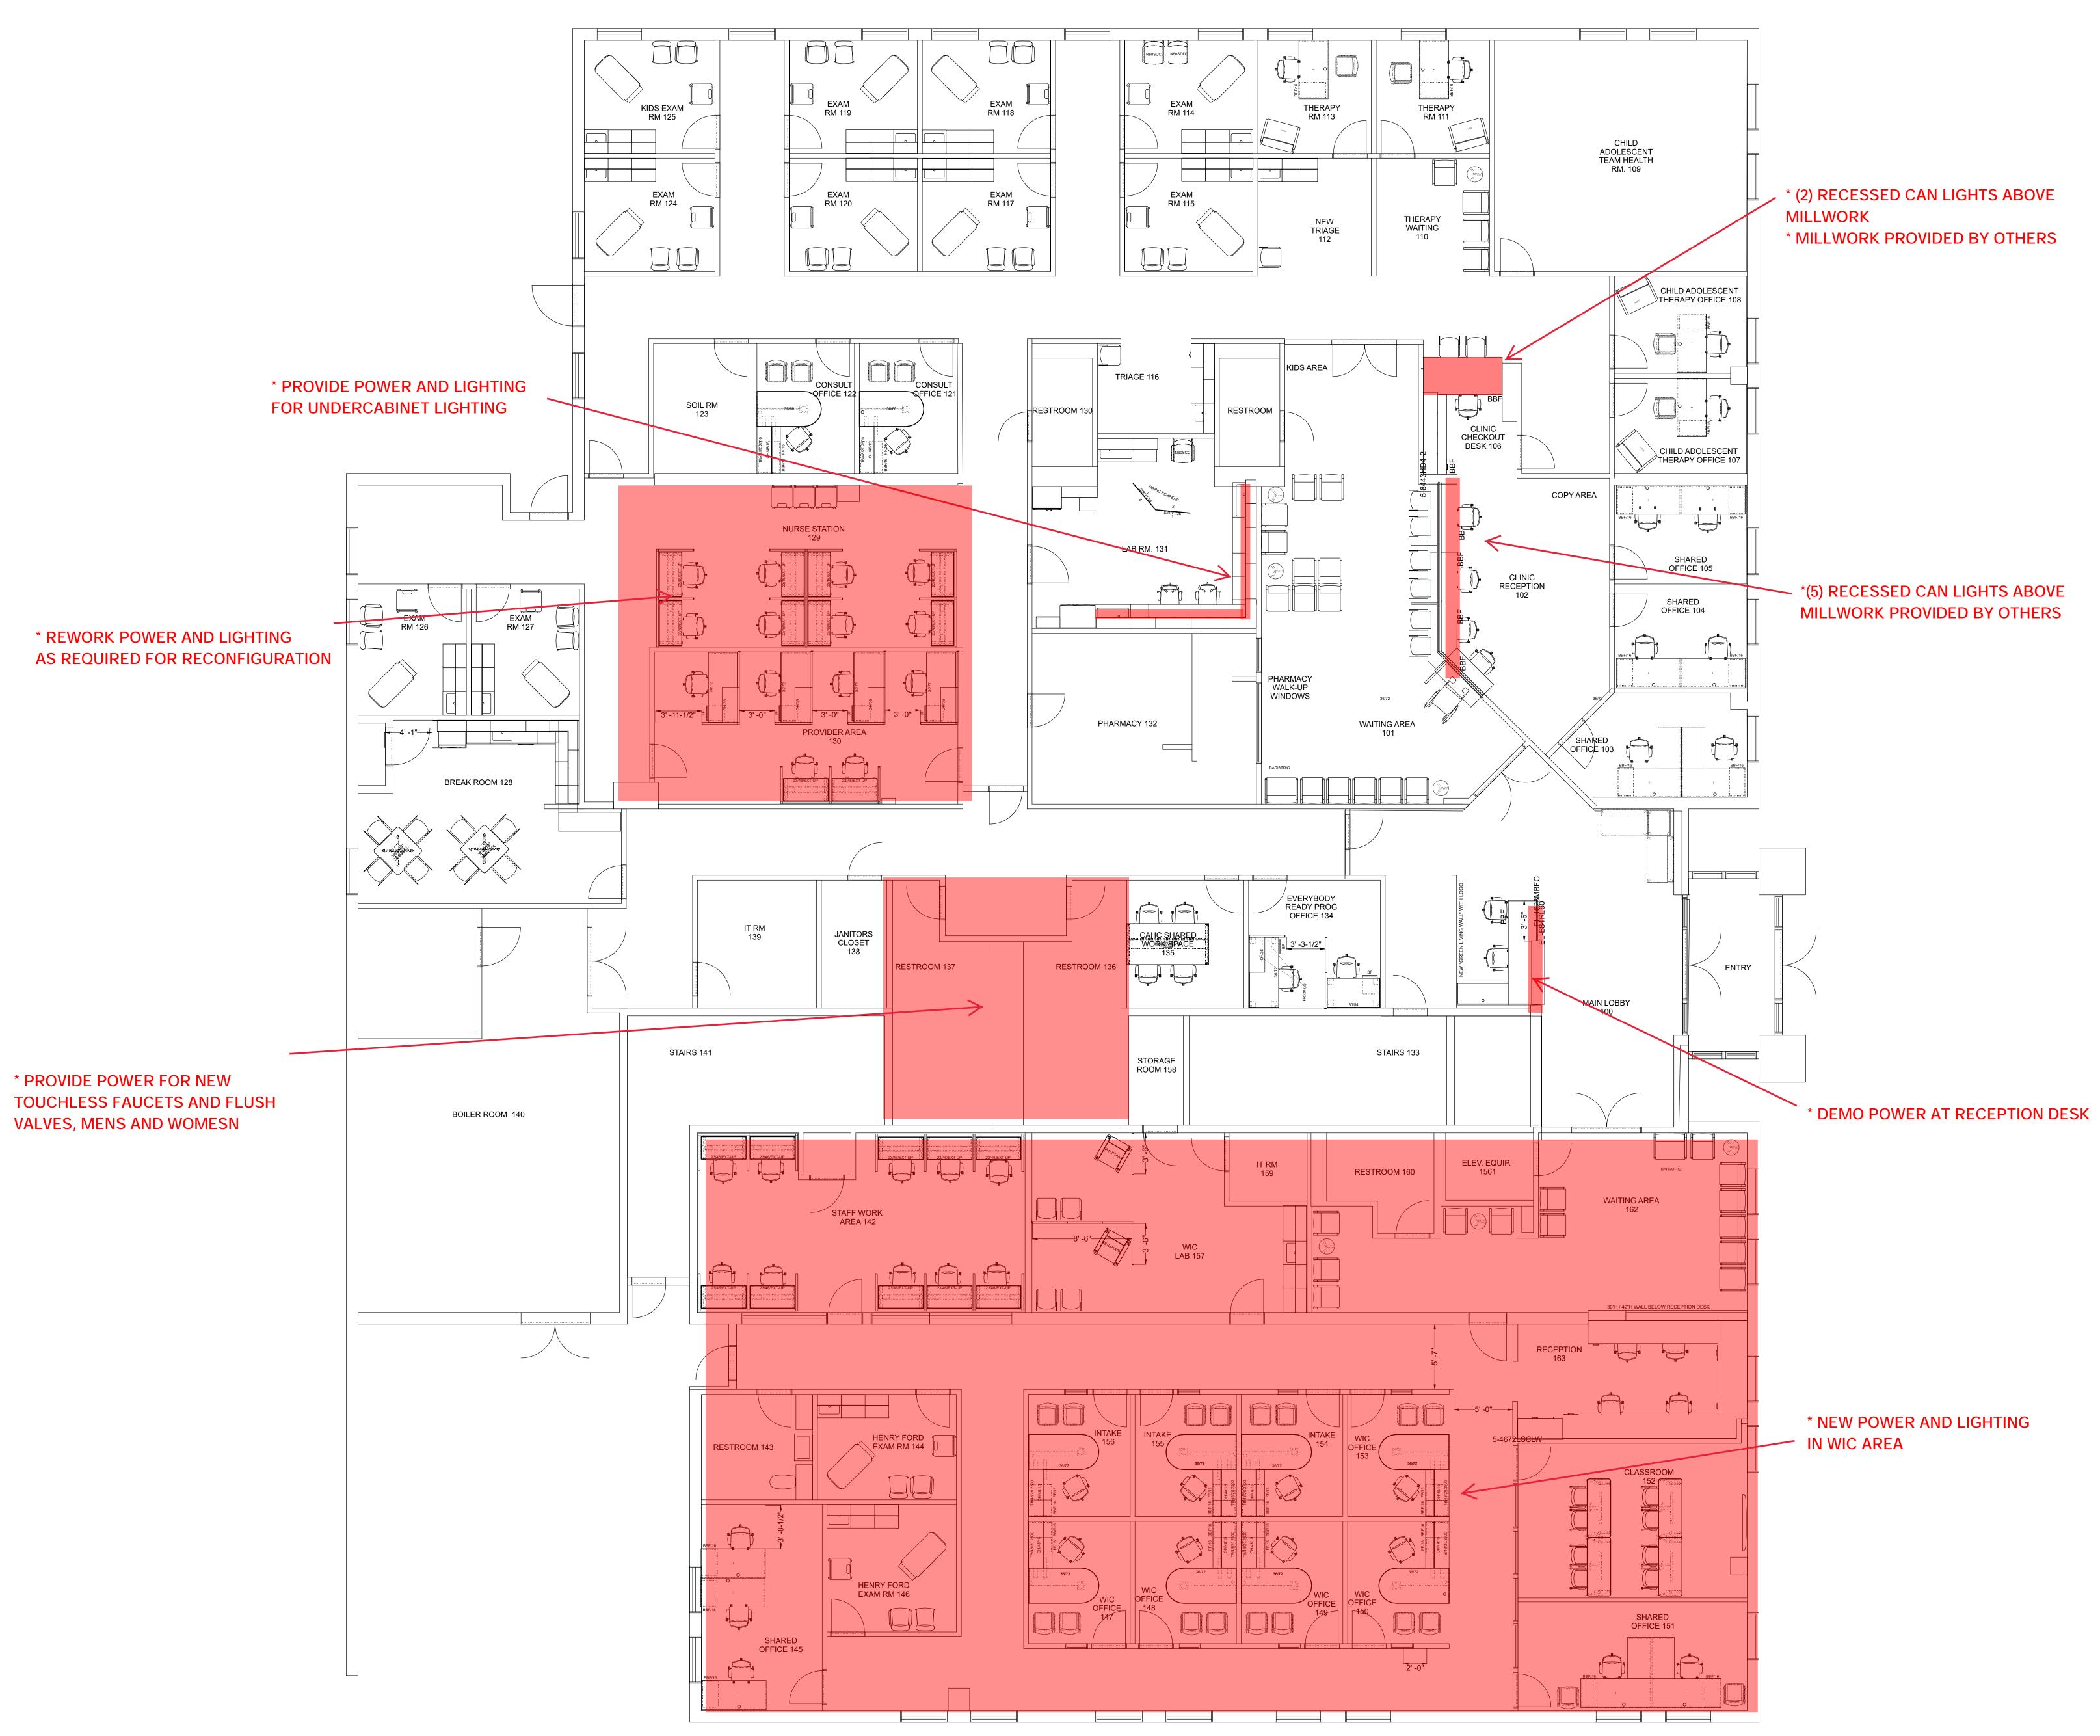


<b>ND</b> ( commercial
NIN commercial interiors
2595 BELLINGHAM TROY, MI 48083 (248) 823-5400 FAX: (248) 823-5401 WWW.YOURNBS.COM
NCIDQ SEAL:
GENERAL NOTES: NOT FOR CONSTRUCTION
ALL STRUCTURAL, MECHANICAL & ELECTRICAL ENGINEERING IS THE RESPONSIBILITY OF OTHERS. ALL FURNITRUE & DESIGN DRAWINGS ARE IN CONFIDENCE & DISSEMINATION MAY NOT BE MAKE WITHOUT PRIOR WRITTEN CONSENT OF NBS. ALL COMMON LAW RIGHTS OF COPYRIGHT AND OTHERWISE ARE HEREBY SPECIFICALLY RESERVED.
FINAL FURNTIURE FIT & PLACEMENT IS SUBJECT TO ANY VARIATION FROM THIS PLAN DUE TO CONSTRUCTION CHANGES, FIELD CONDITIONS, MATERIAL DIFFERENCES OR CHANGES REQUIRED FOR ANY REASON WITH NOTIFICATION TO NBS. IF NBS DID NOT DESIGN THIS PROJECT, NBS DOES NOT ASSUME RESPONSIBILITY FOR THE DESIGN, SPECIFICATION OF PARTS OR APPLICATION OF PRODUCTS INCLUDED IN THIS BID. NBS HAS ONLY RESPONDED TO THE PRICING REQUEST FOR THE
APPROVED BY: DATE:
APPROVED     APPROVED AS NOTED       02/13/23     Issued For Review
ACCESS-6450 MAPLE S PROJECT: 6450 MAPLE- 1ST FLR
6450 MAPLE RD. DEARBORN MI
PROJECT FOLDER:       210990         HEDBERG ORDER #:       [Order entry, Customer PO         ACCOUNT MANAGER:       M RIASHI
ACCOUNT MANAGER: M. RIASHI DESIGNER: D. COAN PROJECT MANAGER F. KREN
DRAWING:
FIRST FLOOR
DRAWING NUMBER:
A-2.10

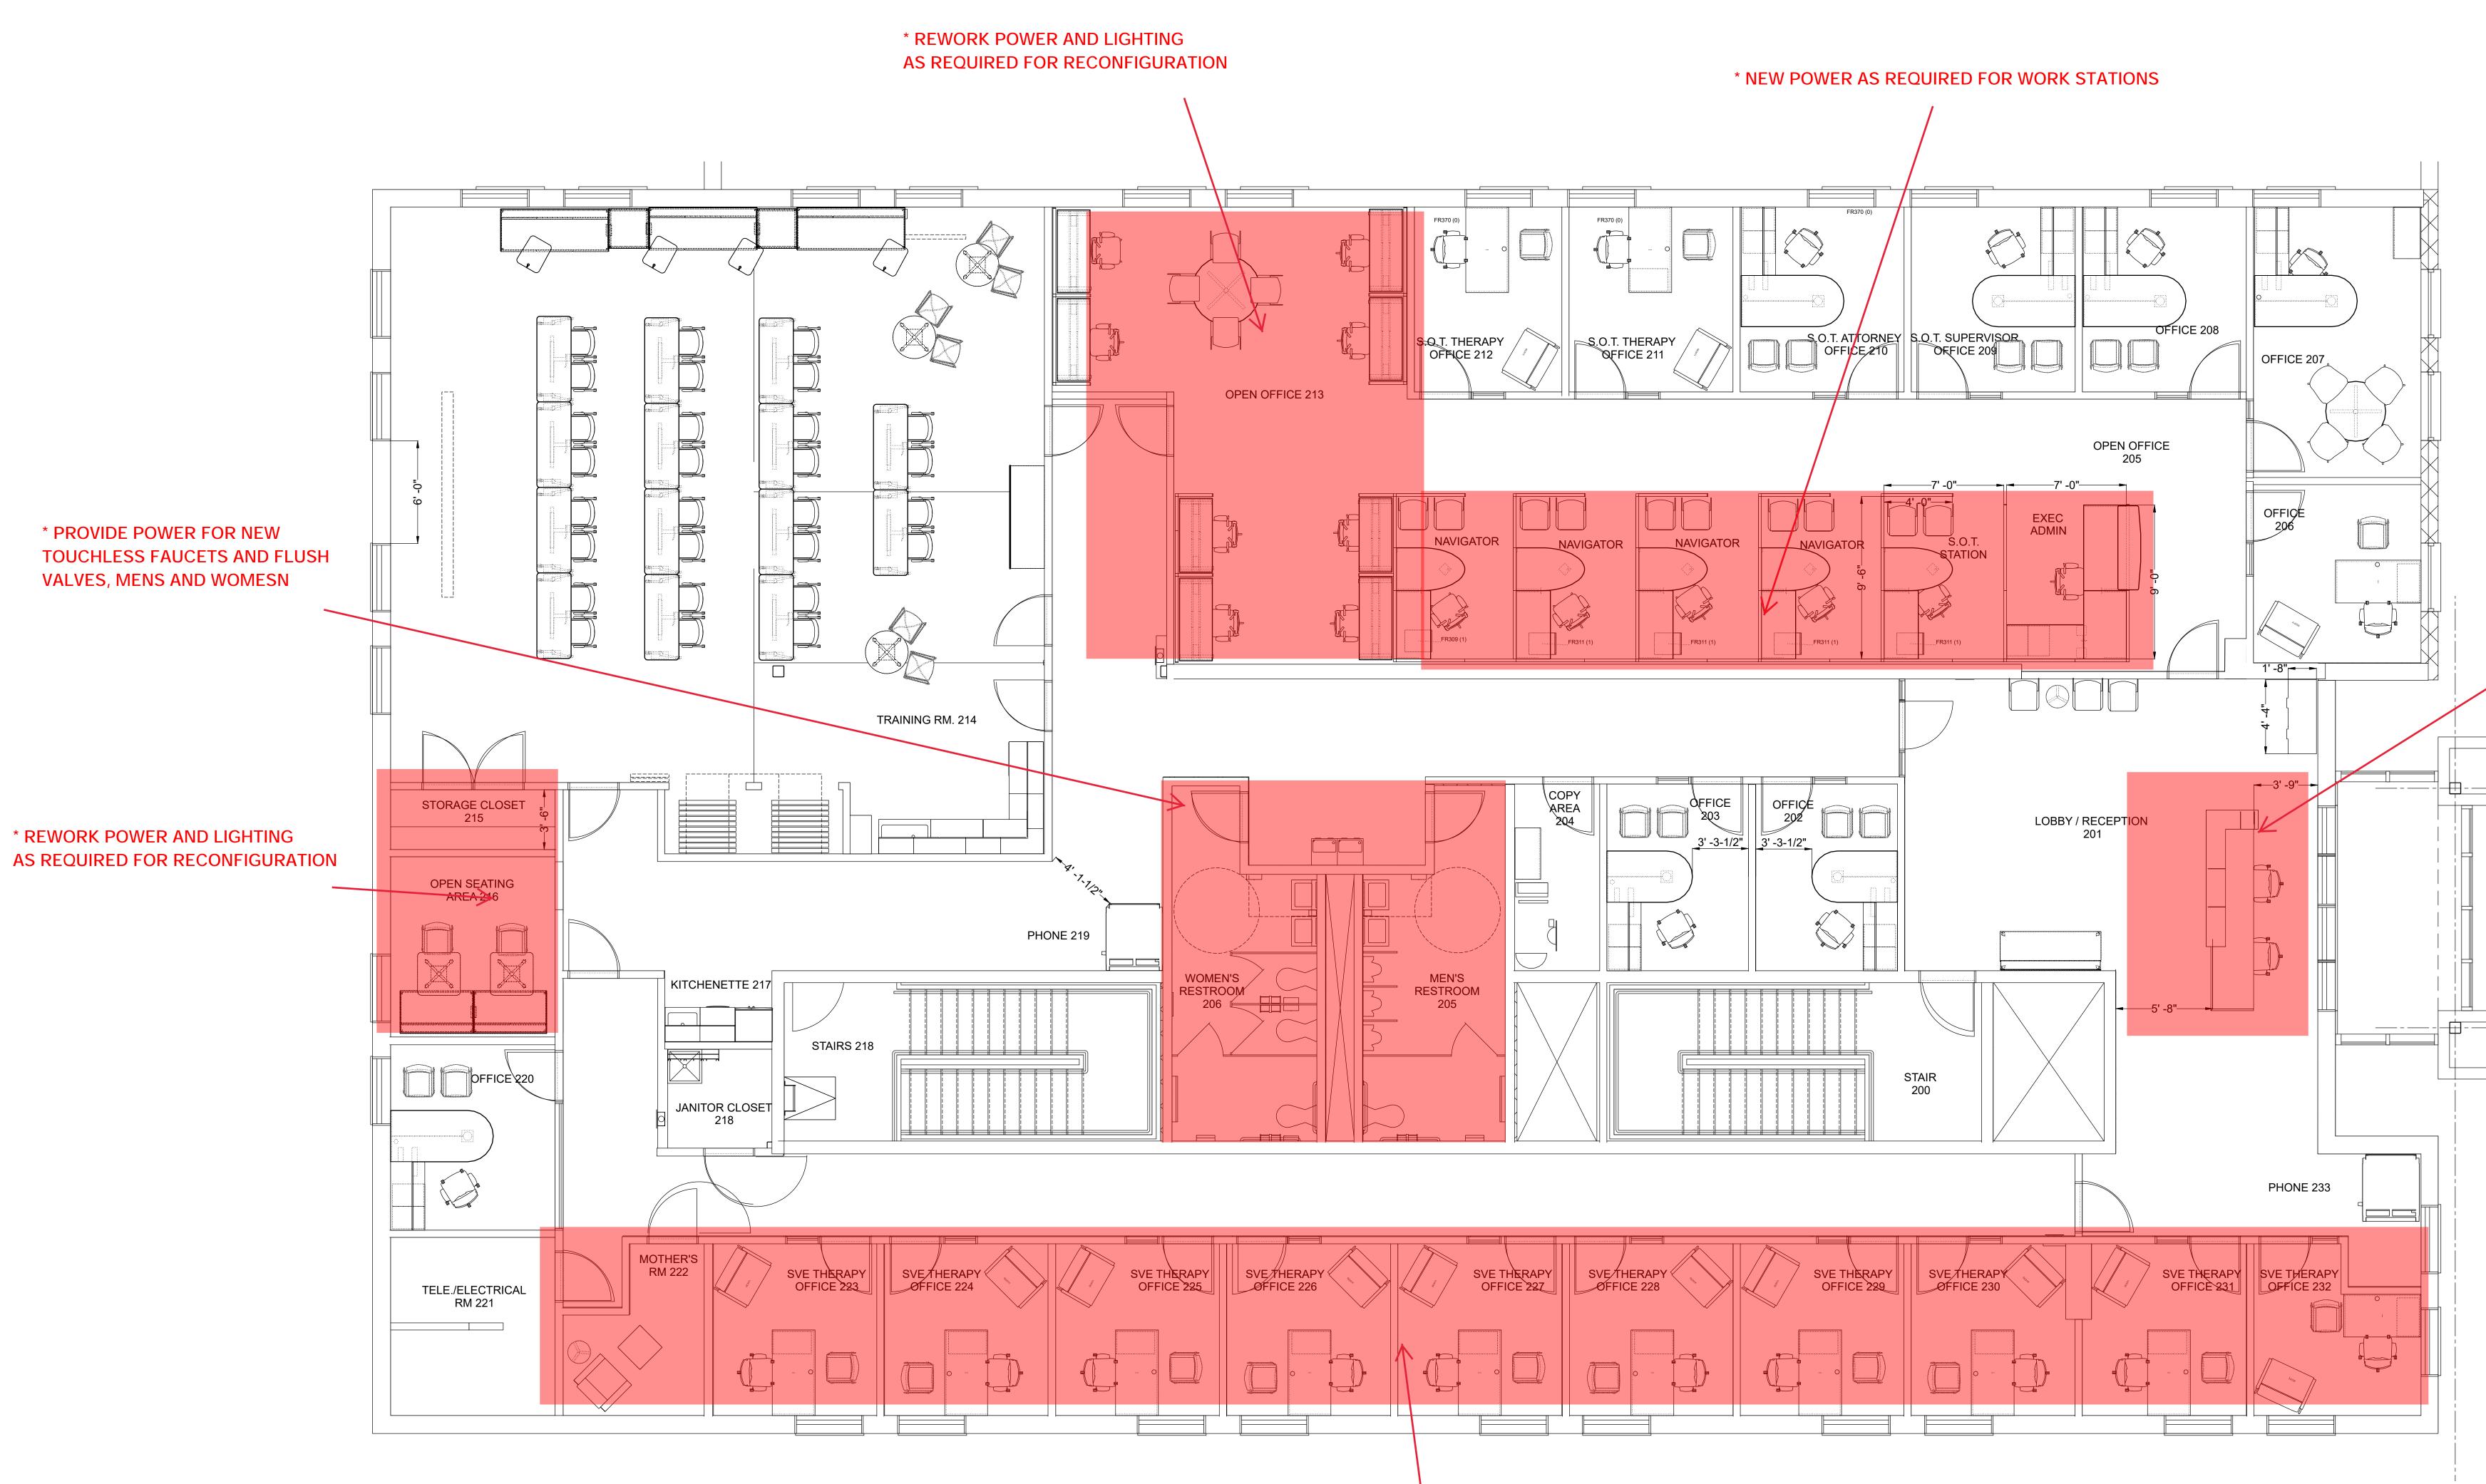


\* REWORK POWER AND LIGHTING AS REQUIRED FOR RECONFIGURATION

	NDBS       commercial commercial interiors         2595       BELLINGHAM TROY, MI 48083         (248)       823-5400         FAX:       (248)         WWW.YOURNBS.COM
* (2) PENDANT LIGHTS TO BE INSTALLED OVER NEW RECEPTION DESK * RECEPTION DESK PROVIDED BY OTHERS	
	GENERAL NOTES:         NOT FOR CONSTRUCTION         ALL STRUCTURAL, MECHANICAL & ELECTRICAL ENGINEERING IS THE RESPONSIBILITY         OF OTHERS.         ALL FURNITRUE & DESIGN DRAWINGS ARE IN CONFIDENCE & DISSEMINATION MAY NOT         BE MAKE WITHOUT PRIOR WRITTEN CONSENT OF NBS. ALL COMMON LAW RIGHTS OF         COPYRIGHT AND OTHERWISE ARE HEREBY SPECIFICALLY RESERVED.         FINAL FURNTIURE FIT & PLACEMENT IS SUBJECT TO ANY VARIATION FROM THIS PLAN         DUE TO CONSTRUCTION CHANGES, FIELD CONDITIONS, MATERIAL DIFFERENCES OR         CHANGES REQUIRED FOR ANY REASON WITH NOTIFICATION TO NBS.         IF NBS DID NOT DESIGN THIS PROJECT, NBS DOES NOT ASSUME RESPONSIBILITY FOR         THE DESIGN, SPECIFICATION OF PRODUCTS INCLUDED IN         THIS BID. NBS HAS ONLY RESPONDED TO THE PRICING REQUEST FOR THE         APPROVED BY:       DATE:
	APPROVED       APPROVED AS NOTED         02/13/23       Issued For Review
	OWNER: ACCESS PROJECT: 2ND FLOOR PLAN 6450 MAPLE ST. DEARBORN MI
	PROJECT FOLDER:       210990         HEDBERG ORDER #:       [Order entry, Customer PO         ACCOUNT MANAGER:       M. RIASHI         DESIGNER:       D. COAN         PROJECT MANAGER       F. KREN
C	DRAWING: VERALL 2ND ELEC AND GHTING PLAN DRAWING NUMBER: A-2.20
	A-2.20

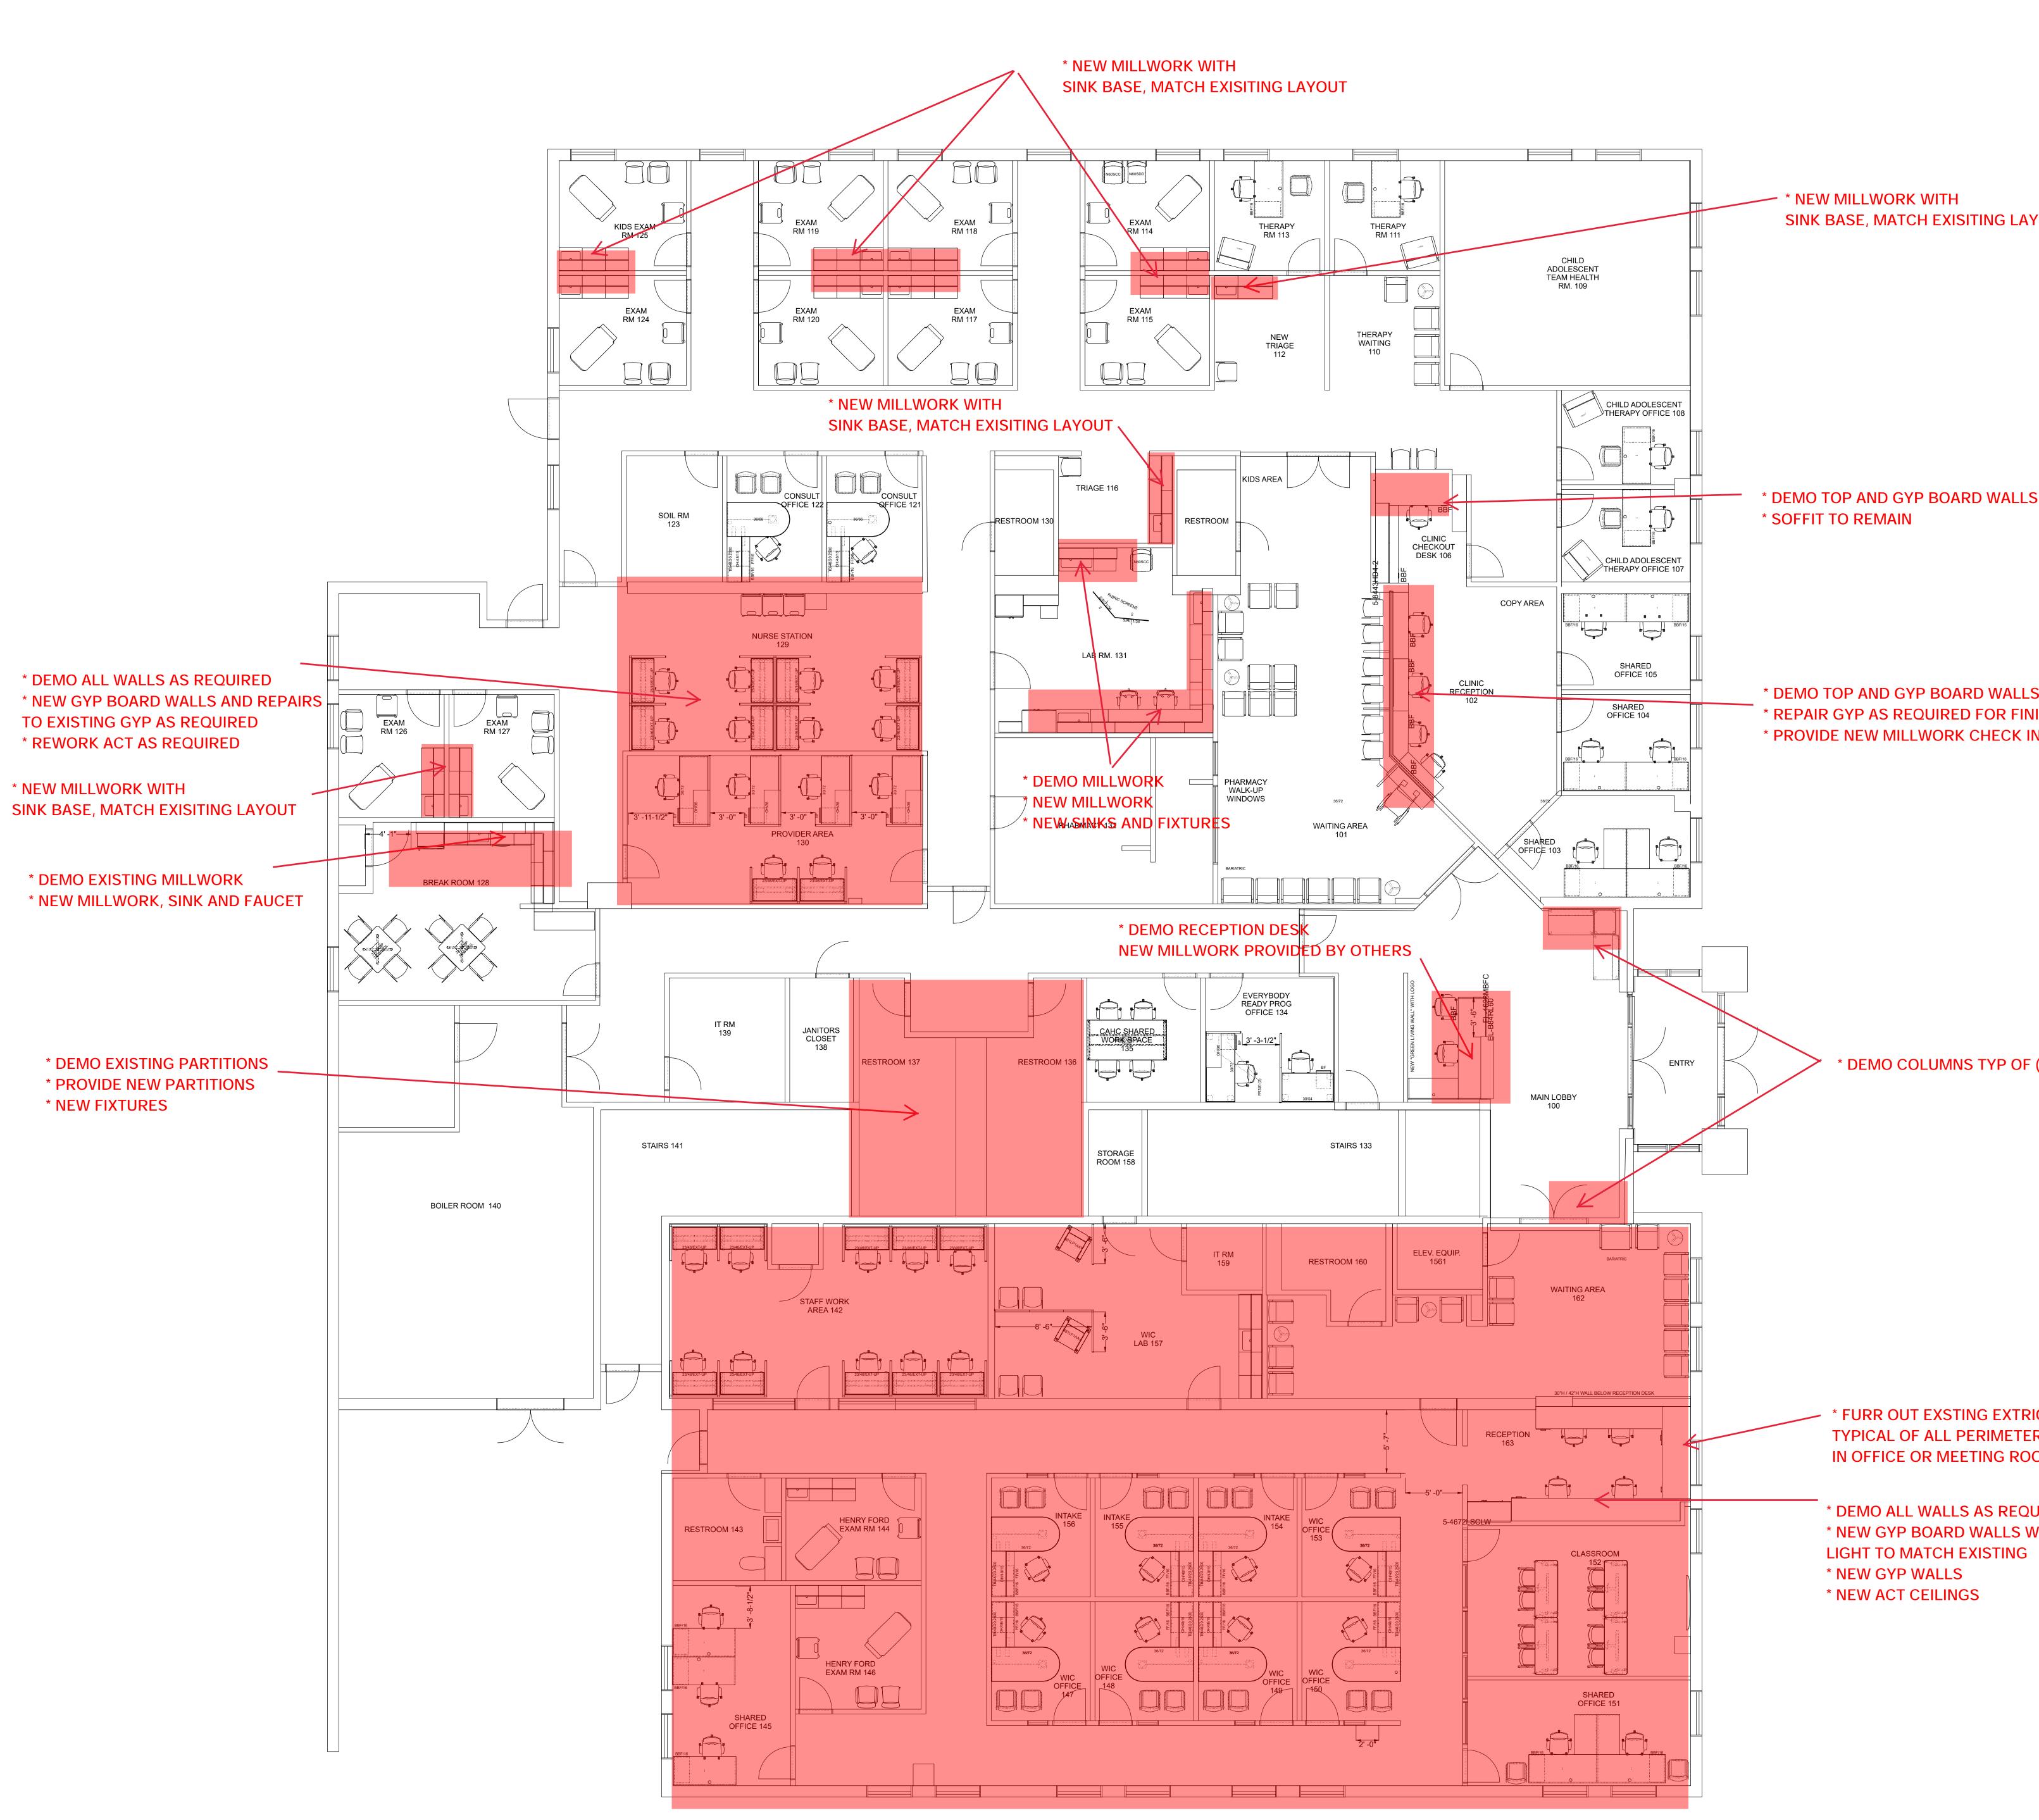

YOUT
S
S JISH OPENING N AREA
(2)
TOR WALL R WALLS OM
UIRED NITH DOOR AND BORROWED


NDQ	commercial interiors
NDO	interiors
2595 BELLINGH/ (248) 823-5400 WWW.YOURNBS	AM TROY, MI 48083 FAX: (248) 823-5401 S.COM
NCIDQ SEAL:	
GENERAL NOTES:	
OF OTHERS. ALL FURNITRUE & DESIGN DR/ BE MAKE WITHOUT PRIOR WR	AL & ELECTRICAL ENGINEERING IS THE RESPONSIBILITY AWINGS ARE IN CONFIDENCE & DISSEMINATION MAY NOT ITTEN CONSENT OF NBS. ALL COMMON LAW RIGHTS OF ARE HEREBY SPECIFICALLY RESERVED.
FINAL FURNTIURE FIT & PLACE DUE TO CONSTRUCTION CHAN CHANGES REQUIRED FOR ANY IF NBS DID NOT DESIGN THIS F THE DESIGN, SPECIFICATION (	EMENT IS SUBJECT TO ANY VARIATION FROM THIS PLAN IGES, FIELD CONDITIONS, MATERIAL DIFFERENCES OR Y REASON WITH NOTIFICATION TO NBS. PROJECT, NBS DOES NOT ASSUME RESPONSIBILITY FOR OF PARTS OR APPLICATION OF PRODUCTS INCLUDED IN
APPROVED BY:	DATE:
	APPROVED AS NOTED
02/13/23	Issued For Review
	S-6450 MAPLE ST.
	6450 MAPLE - 1ST FLR
6450 MAPLE RD. DEARBORN MI	
PROJECT FOLDER: HEDBERG ORDER #	210990 t: [Order entry, Customer PO
ACCOUNT MANAGE	R: M. RIASHI D. COAN
PROJECT MANAGE	
DRAWING:	
FIRS	FLOOR
ND M	PENTRY
DRAWING NUMBER:	-8.10

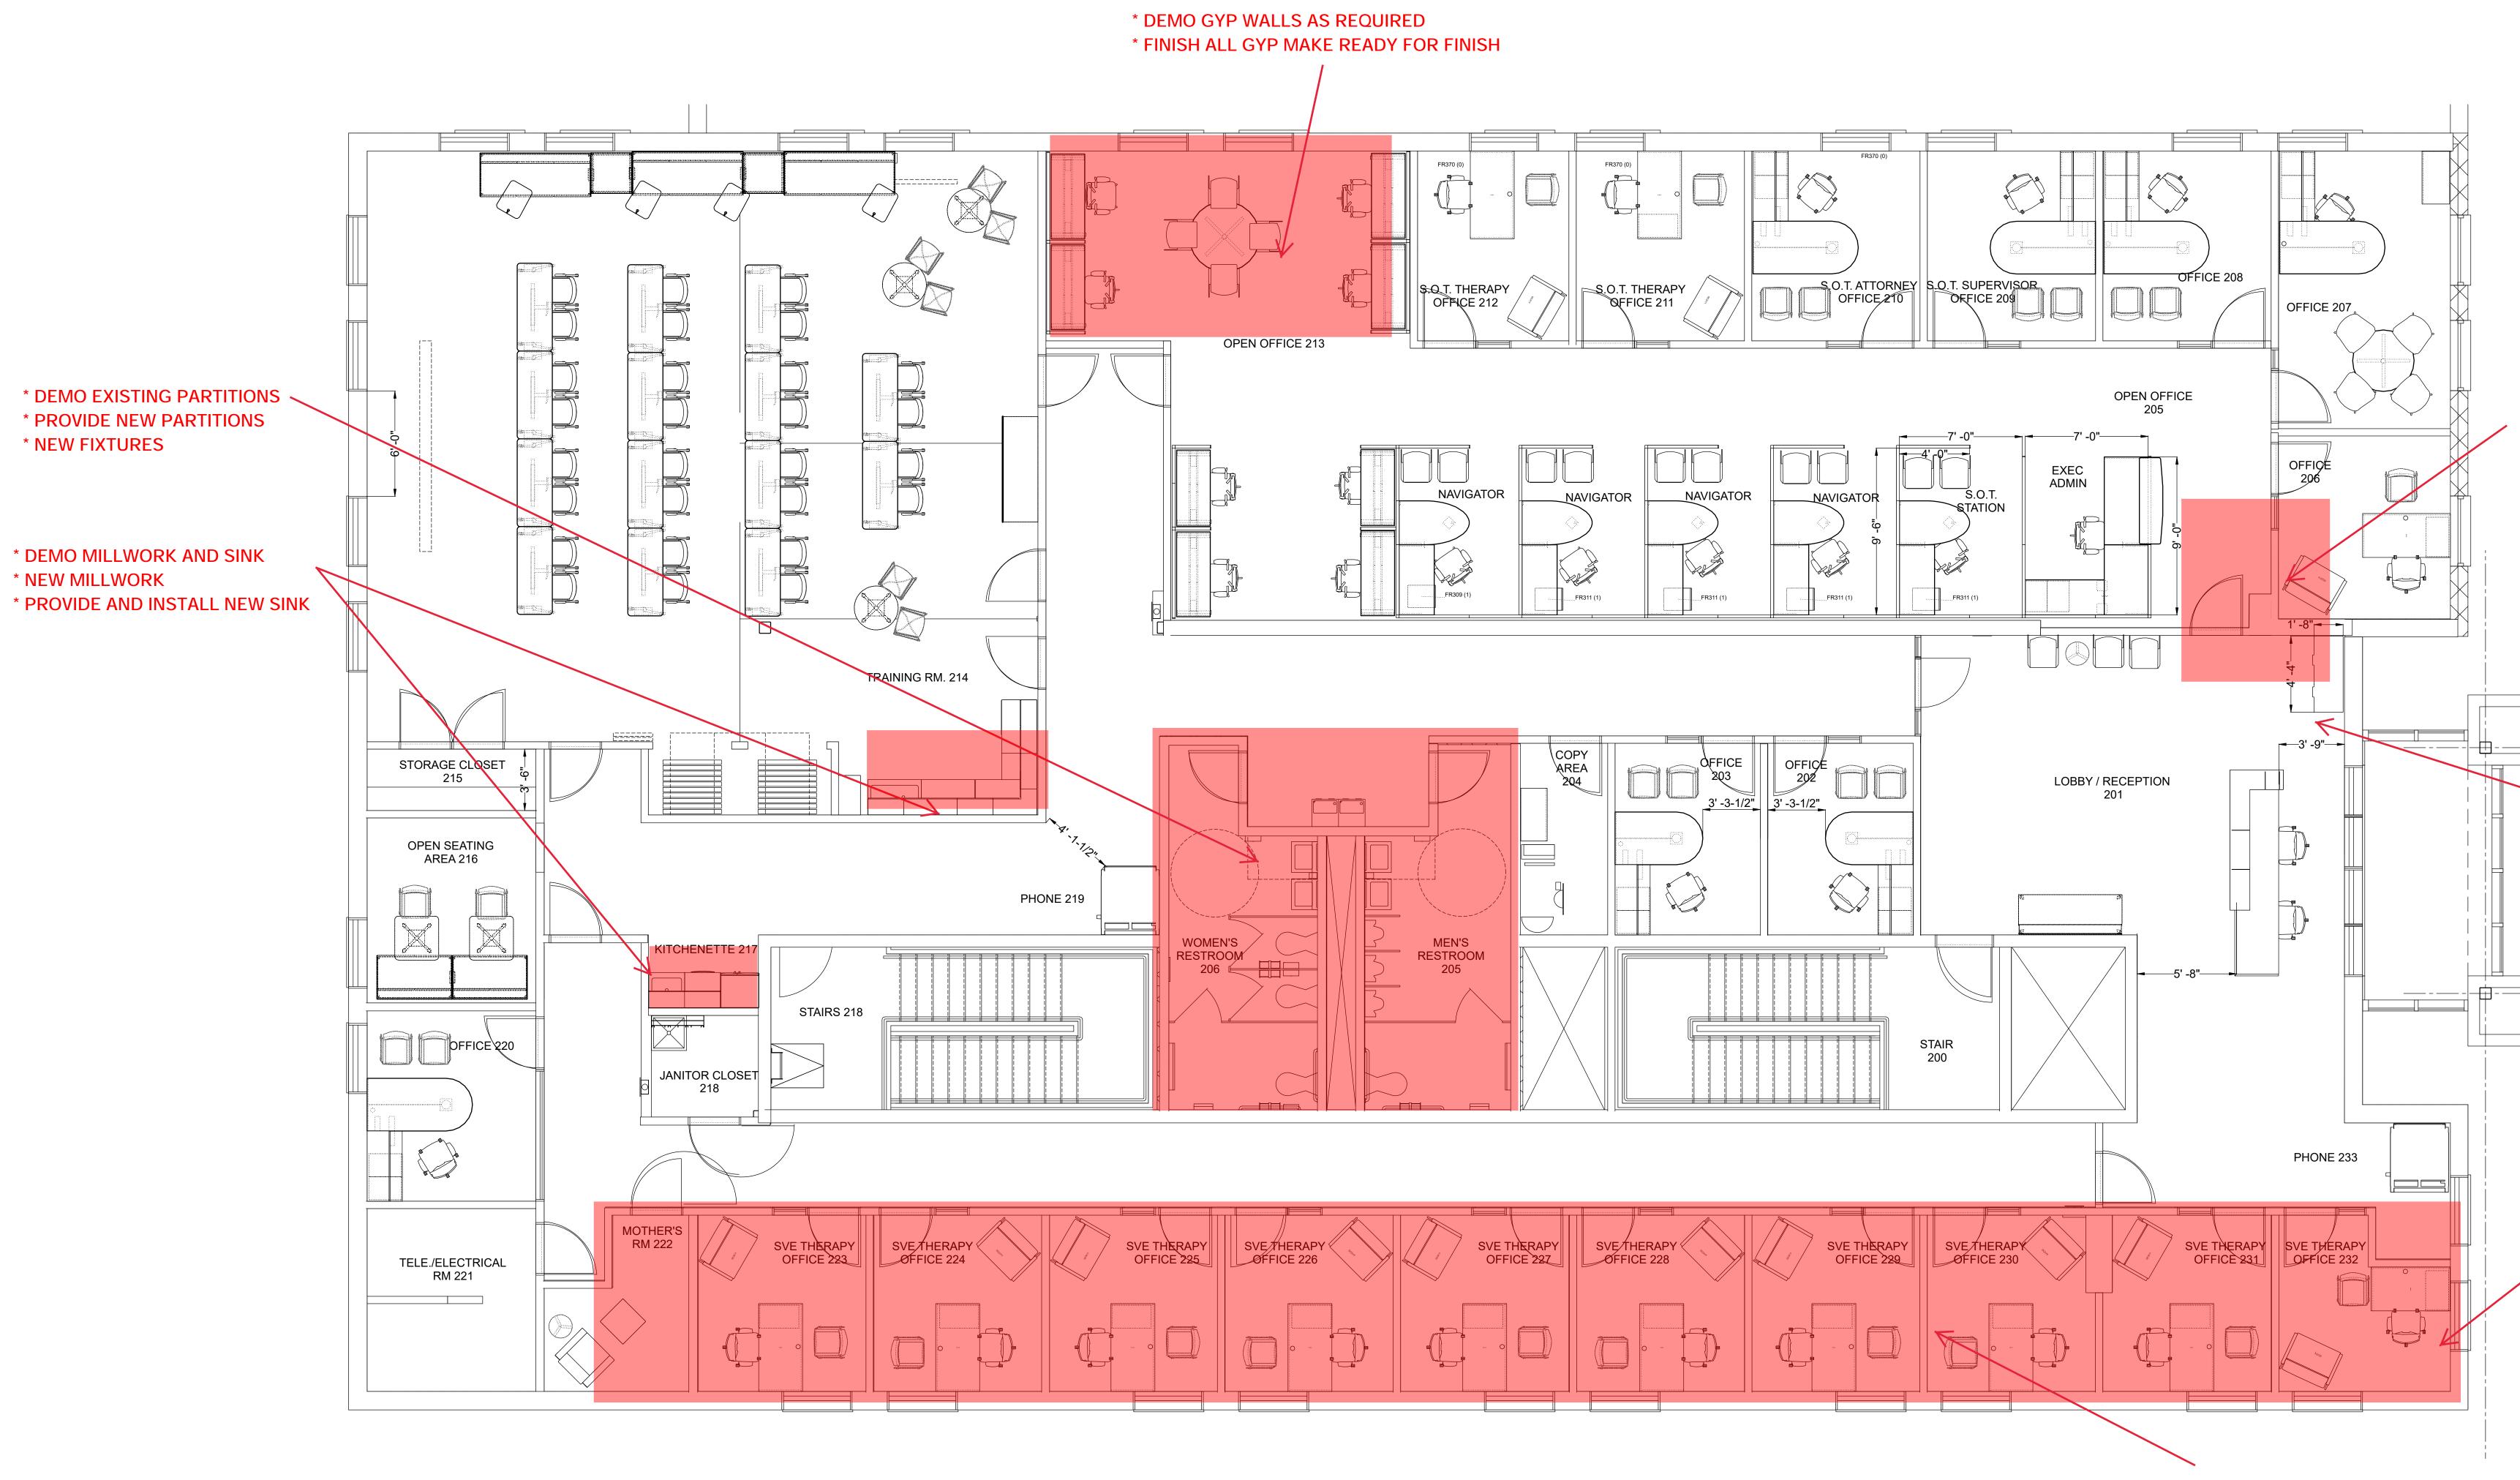

\* DEMO DOORS


\* NEW DOOR AND SIDE LIGHTS

	State         State <th< th=""></th<>
* DEMO AND RELOCATE EXISTING DOOR	
* DEMO EXISTING MILLWORK NEW MILLWORK BY OTHERS	
	GENERAL NOTES: NOT FOR CONSTRUCTION ALL STRUCTURAL, MECHANICAL & ELECTRICAL ENGINEERING IS THE RESPONSIBILITY OF OTHERS. ALL FURNITRUE & DESIGN DRAWINGS ARE IN CONFIDENCE & DISSEMINATION MAY NOT BE MAKE WITHOUT PRIOR WRITTEN CONSENT OF NBS. ALL COMMON LAW RIGHTS OF COPYRIGHT AND OTHERWISE ARE HEREBY SPECIFICALLY RESERVED. FINAL FURNTIURE FIT & PLACEMENT IS SUBJECT TO ANY VARIATION FROM THIS PLAN DUE TO CONSTRUCTION CHANGES, FIELD CONDITIONS, MATERIAL DIFFERENCES OR CHANGES REQUIRED FOR ANY REASON WITH NOTIFICATION TO NBS. IF NBS DID NOT DESIGN THIS PROJECT, NBS DOES NOT ASSUME RESPONSIBILITY FOR THE DESIGN, SPECIFICATION OF PARTS OR APPLICATION OF PRODUCTS INCLUDED IN THIS BID. NBS HAS ONLY RESPONDED TO THE PRICING REQUEST FOR THE APPROVED BY: DATE:
* FURR OUT EXSTING EXTRIOR WALL TYPICAL OF ALL PERIMETER WALLS IN OFFICE OR MEETING ROOM	APPROVED APPROVED AS NOTED   02/13/23 Issued For Review
	ACCESS PROJECT: 2ND FLOOR PLAN 6450 MAPLE ST. DEARBORN MI
	PROJECT FOLDER: 21090 HEDBERG ORDER #: [Order entry, Customer PO ACCOUNT MANAGER: M. RIASHI DESIGNER: D. COAN PROJECT MANAGER F. KREN DRAWING: DRAWING:
	AND DRAWIN MARE LWORK A-8.20

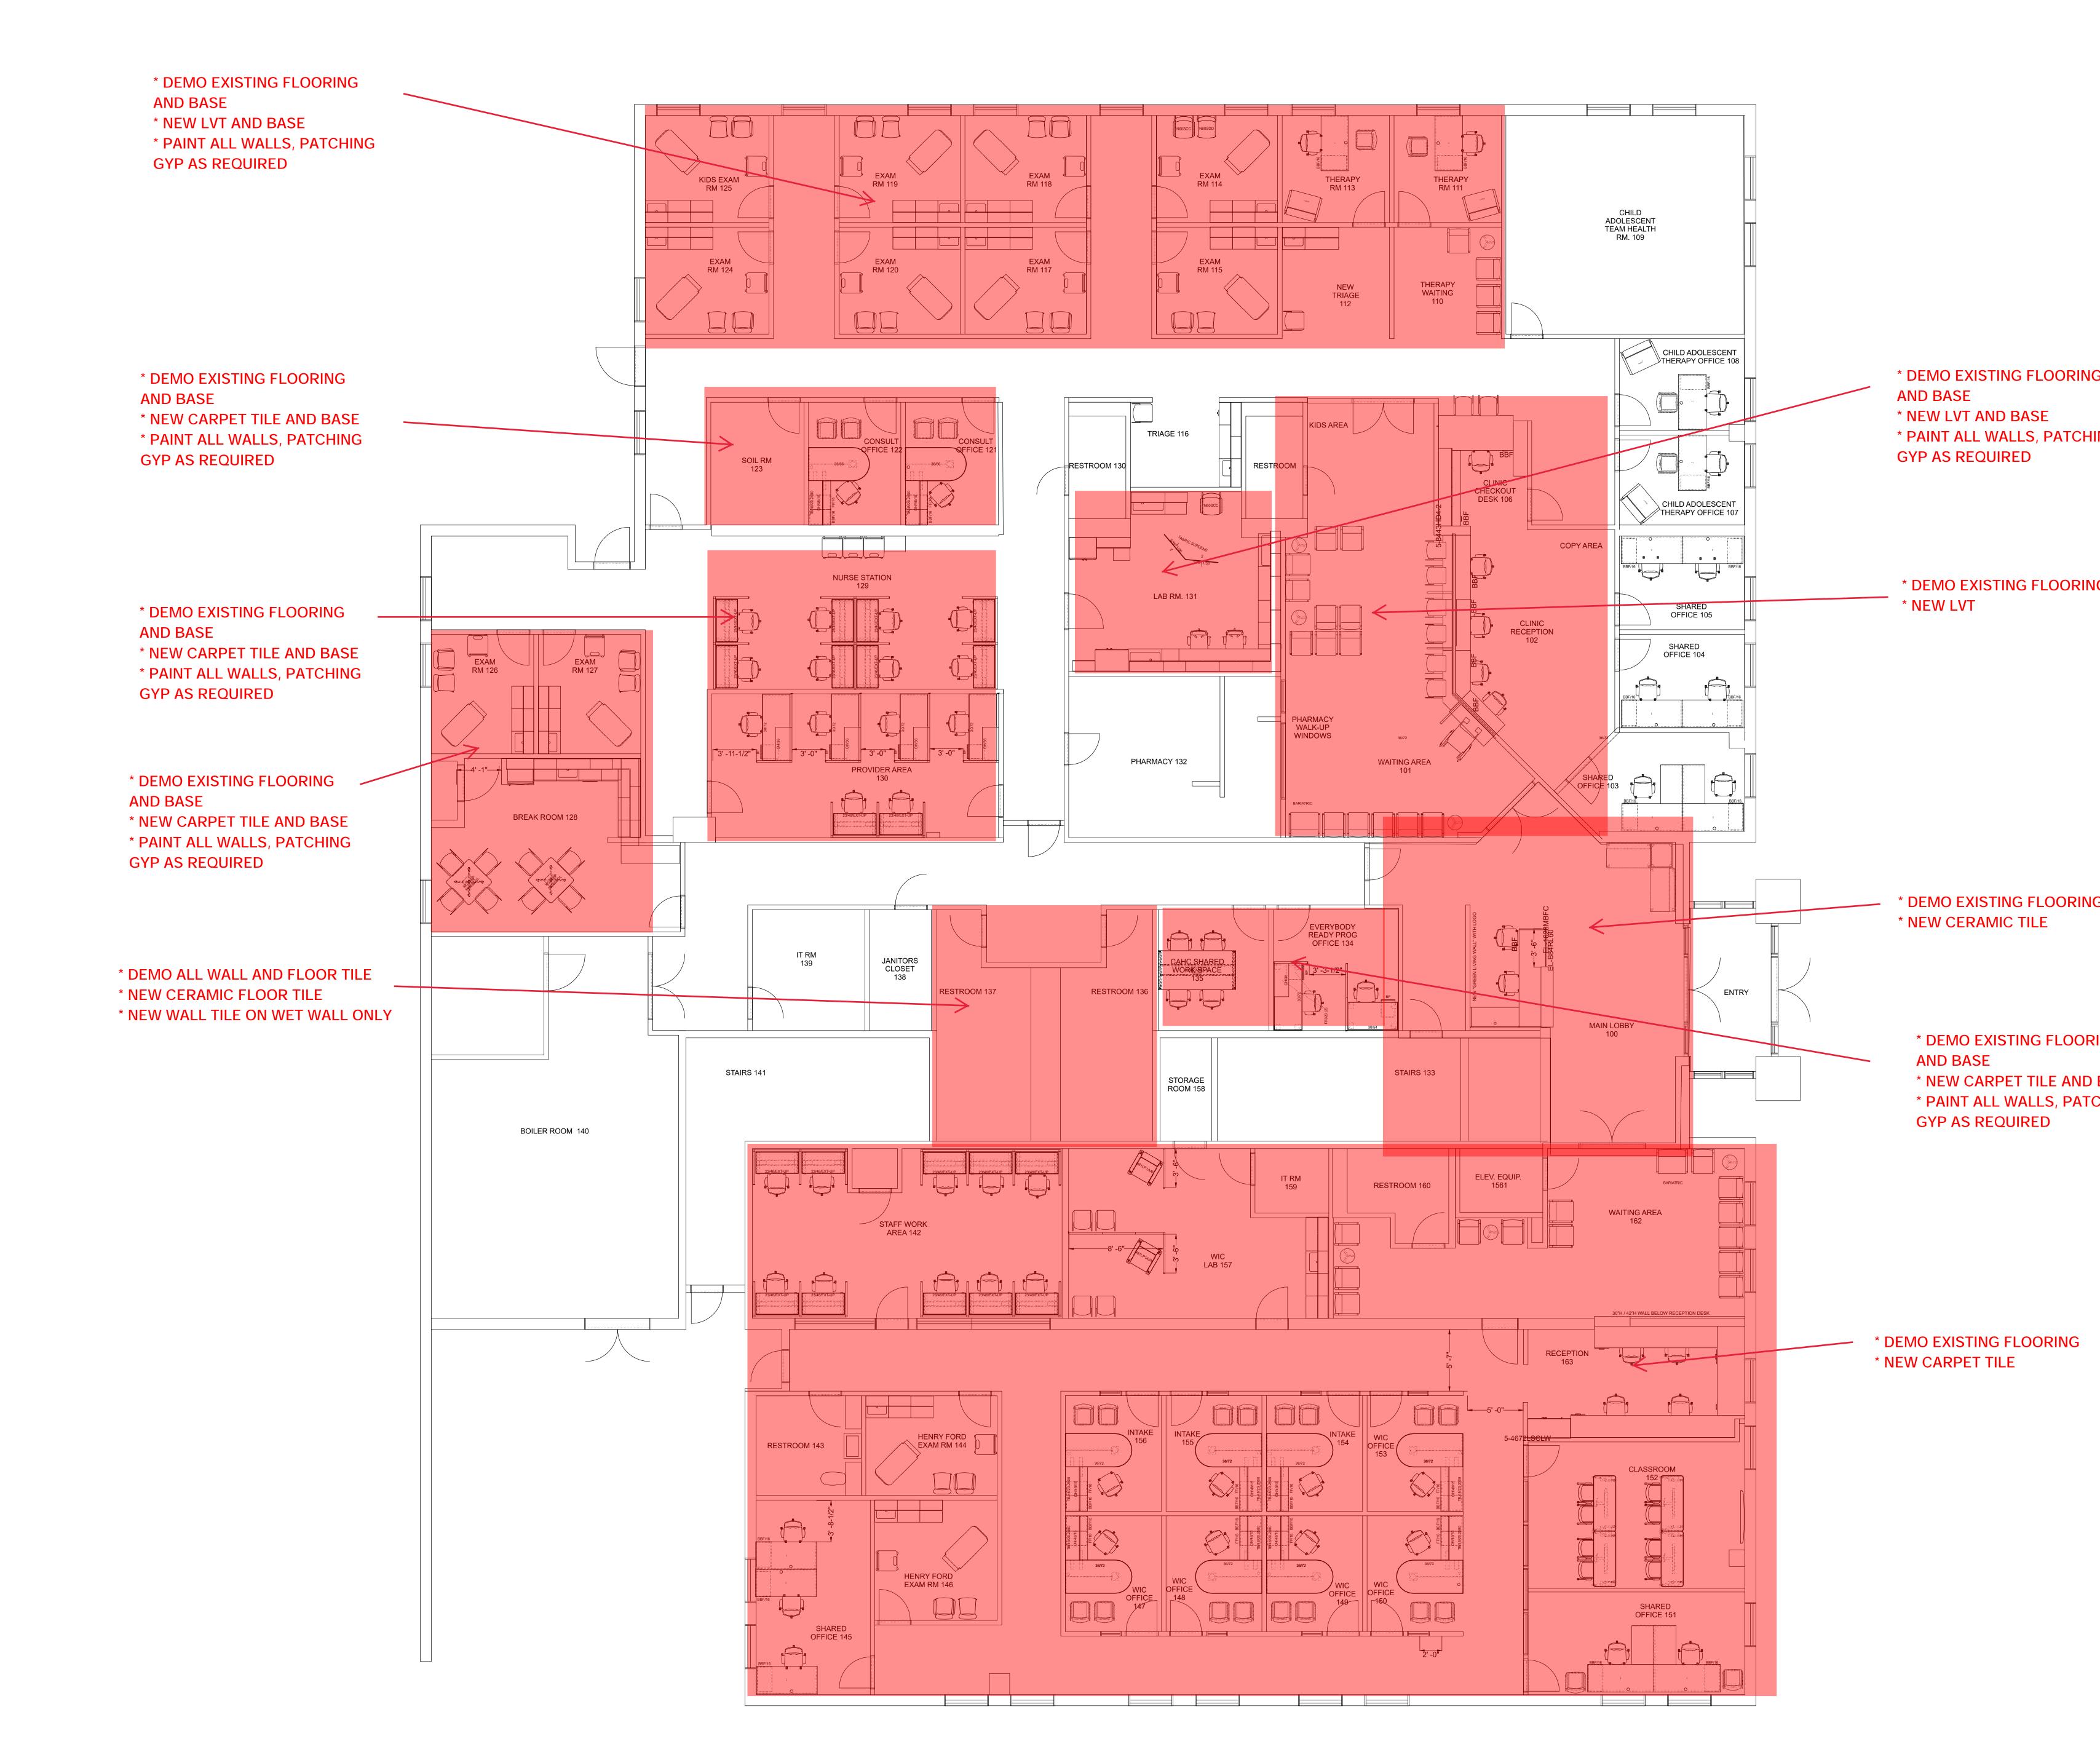

IG			
IING			
NG			
IG			
RING			
) BASE CHING			

NBS	commercial interiors	
2595 BELLINGHAM TROY, MI 48083 (248) 823-5400 FAX: (248) 823-5401		
WWW.YOURNBS.COM		
NCIDQ SEAL:		
GENERAL NOTES:		
NOT FOR CONSTRUCTION ALL STRUCTURAL, MECHANICA OF OTHERS. ALL FURNITRUE & DESIGN DRA BE MAKE WITHOUT PRIOR WRT	AL & ELECTRICAL ENGINEERING IS THE RESPONSIBILITY WINGS ARE IN CONFIDENCE & DISSEMINATION MAY NOT TTEN CONSENT OF NBS. ALL COMMON LAW RIGHTS OF ARE HEREBY SPECIFICALLY RESERVED.	
DUE TO CONSTRUCTION CHAN CHANGES REQUIRED FOR ANY IF NBS DID NOT DESIGN THIS F THE DESIGN, SPECIFICATION O THIS BID. NBS HAS ONLY RESP	MENT IS SUBJECT TO ANY VARIATION FROM THIS PLAN IGES, FIELD CONDITIONS, MATERIAL DIFFERENCES OR ' REASON WITH NOTIFICATION TO NBS. PROJECT, NBS DOES NOT ASSUME RESPONSIBILITY FOR DF PARTS OR APPLICATION OF PRODUCTS INCLUDED IN PONDED TO THE PRICING REQUEST FOR THE	
APPROVED BY:	DATE:	
	APPROVED AS NOTED	
02/13/23	Issued For Review	
	6-6450 MAPLE ST.	
	6450 MAPLE- 1ST FLR	
6450 MAPLE RD.		
DEARBORN MI		
PROJECT FOLDER: 210990 HEDBERG ORDER #: [Order entry, Customer PO		
ACCOUNT MANAGER: M. RIASHI DESIGNER: D. COAN PROJECT MANAGER F. KREN		
DRAMAING: FIRST FLOOR		
FLOORING		
AND FINISH PLAN		
A-9.10		
	•	

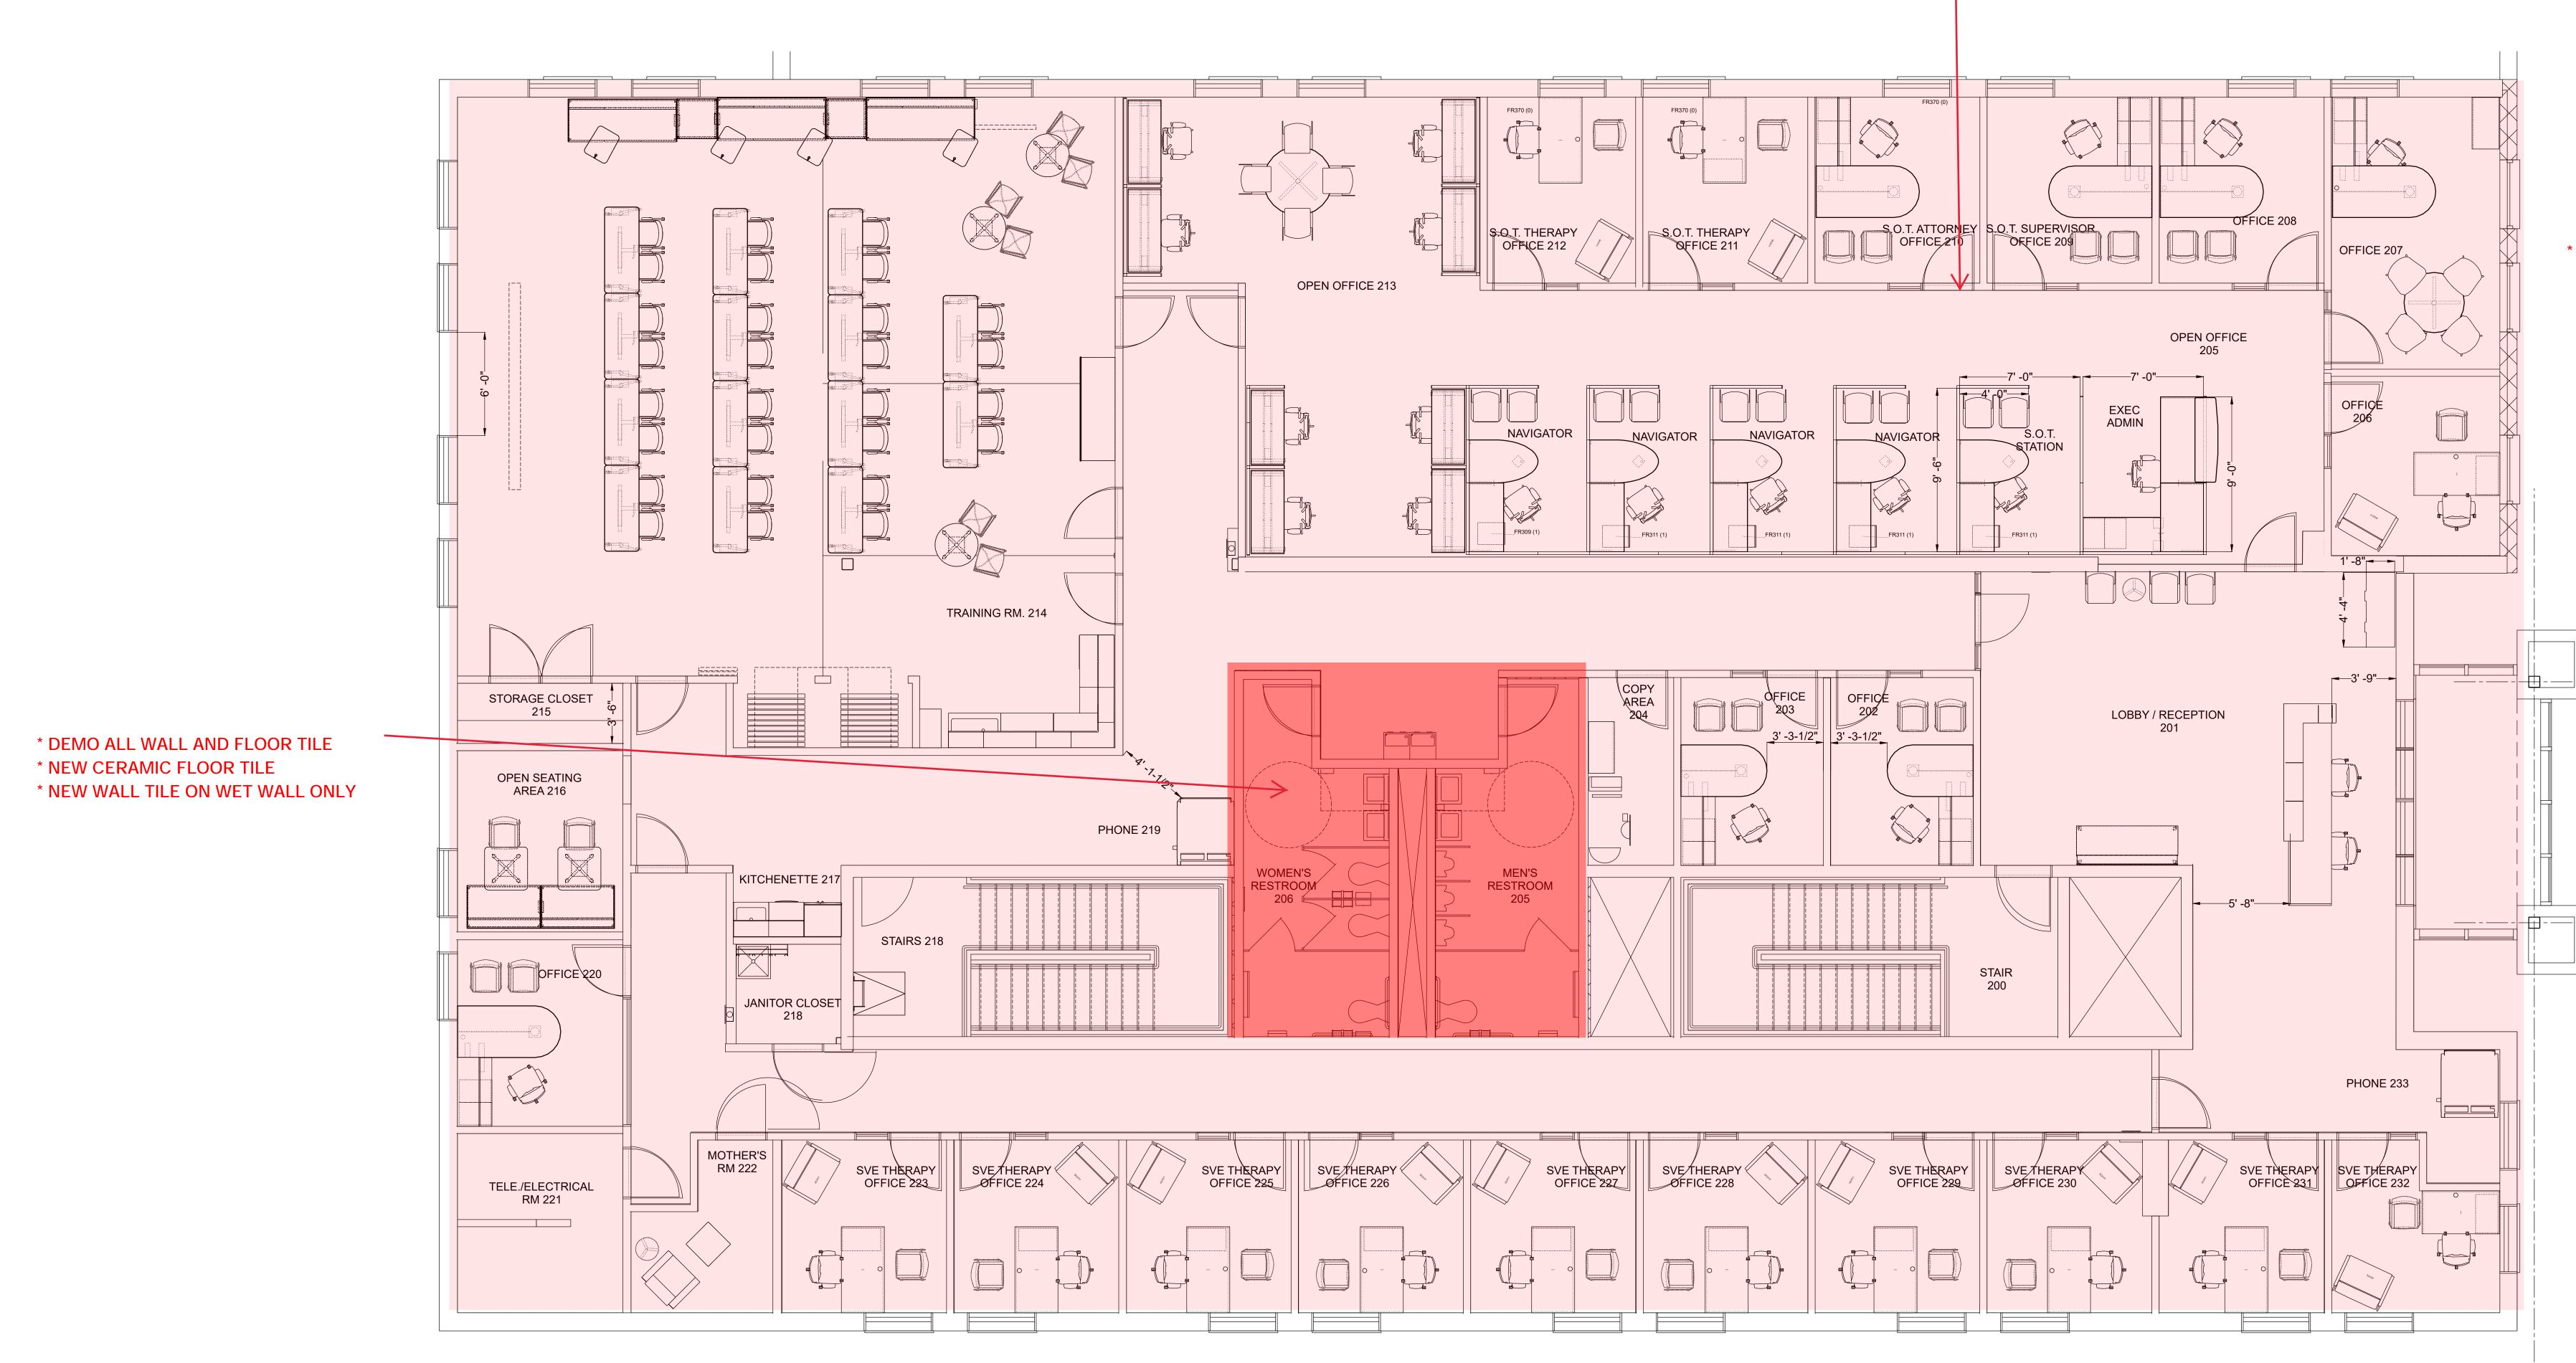



\* DEMO ALL FLOORING \* NEW CARPET TILE FLOORING SECOND FLOOR

	States         States           States         States           States         States
ALL OF SECOND FLOOR TO BE PAINTED	
	GENERAL NOTES:         NOT FOR CONSTRUCTION         ALL STRUCTURAL, MECHANICAL & ELECTRICAL ENGINEERING IS THE RESPONSIBILITY         OF HERS.         ALL FURNITRUE & DESIGN DRAWINGS ARE IN CONFIDENCE & DISSEMINATION MAY NOT         BE MAKE WITHOUT PRIOR WRITTEN CONSENT OF NBS. ALL COMMON LAW RIGHTS OF         COPYRIGHT AND OTHERWISE ARE HEREBY SPECIFICALLY RESERVED.         FINAL FURNTIURE FIT & PLACEMENT IS SUBJECT TO ANY VARIATION FROM THIS PLAN         DUE TO CONSTRUCTION CHANGES, FIELD CONDITIONS, MATERIAL DIFFERENCES OR         CHANGES REQUIRED FOR ANY REASON WITH NOTIFICATION TO NBS.         IF NBS DID NOT DESIGN THIS PROJECT, NBS DOES NOT ASSUME RESPONSIBILITY FOR         THE DESIGN, SPECIFICATION OF PARTS OR APPLICATION OF PRODUCTS INCLUDED IN         THIS BID. NBS HAS ONLY RESPONDED TO THE PRICING REQUEST FOR THE         APPROVED BY:       DATE:         APPROVED BY:       DATE:         02/13/23       ISSUED FOR REVIEW
	OWNER: ACCESS PROJECT: 2ND FLOOR PLAN 6450 MAPLE ST. DEARBORN MI
	PROJECT FOLDER: 21090 HEDBERG ORDER #: [Order entry, Customer PO ACCOUNT MANAGER: M. RIASHI DESIGNER: D. COAN PROJECT MANAGER F. KREN DRAWING: OVERALL DRAWING: OVERALL DRAWING: DUBER: PLAN AND FINISH DRAWING NUMBER: PLAN A-9,20